


15-193-19000-00-00

Give All Information Completely
Make Required Affidavit
Mail or Deliver Report to:
Conservation Division
State Corporation Commission
212 North Market, Insurance Bldg.
Wichita, Kansas

WELL PLUGGING RECORD

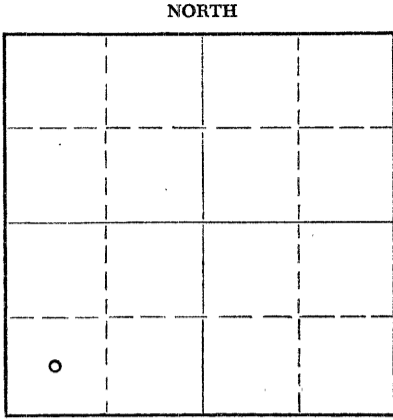

Locate well correctly on above
Section Plat

Thomas County. Sec. 29 Twp. 6 Rge. 32 (E) W (W)
Location as "NE/CNW/SW" or footage from lines. center SW/4 SW/4
Lease Owner Schuerman-Eisenhower
Lease Name Ziegelmeier Well No. 1
Office Address 633 Mayo Building, Tulsa, Oklahoma
Character of Well (completed as Oil, Gas or Dry Hole) Dry Hole
Date well completed December 28 19 59
Application for plugging filed January 4 19 60
Application for plugging approved by telephone December 28 19 59
Plugging commenced December 28 19 59
Plugging completed December 28 19 59
Reason for abandonment of well or producing formation Dry Hole

If a producing well is abandoned, date of last production _____ 19____
Was permission from the Conservation Division or its agents before plugging was commenced? Yes

Name of Conservation Agent who supervised plugging of this well Regional Agent
Producing formation None Depth to top _____ Bottom _____ Total Depth of Well 4700 Feet
Show depth and thickness of all water, oil and gas formations.

OIL, GAS OR WATER RECORDS

CASING RECORD

FORMATION	CONTENT	FROM	TO	SIZE	PUT IN	PULLED OUT
Lansing	Water	4046	4298	8 5/8"	220'	None
Cherokee	Water	4472	4484			

Describe in detail the manner in which the well was plugged, indicating where the mud fluid was placed and the method or methods used in introducing it into the hole. If cement or other plugs were used, state the character of same and depth placed, from _____ feet to _____ feet for each plug set.

Filled hole with heavy mud to 500'. Dumped hulls rolled in sack plug and spotted 20 sacks cement through drill pipe. Fill with heavy mud to 210'. Dumped hulls rolled in sack plug and spotted 20 sacks cement through drill pipe. Filled with heavy mud to 40'. Filled with hulls and 10 sacks cement to bottom of cellar.

ST. FILE
JAN 7 1960
CONSERVATION DIVISION
WICHITA, KANSAS
1-7-60

(If additional description is necessary, use BACK of this sheet)

Name of Plugging Contractor Badger Drillers, Inc.
Address Mayo Building, Tulsa, Oklahoma

STATE OF Oklahoma, COUNTY OF Tulsa, ss.
W. Keith Schuerman, Partner (conservator of the above-described well, being first duly sworn on oath, says: That I have knowledge of the facts, statements, and matters herein contained and the log of the above-described well as filed and that the same are true and correct. So help me God.

(Signature) W. Keith Schuerman
633 Mayo Building, Tulsa, Oklahoma
(Address)

SUBSCRIBED AND SWORN TO before me this 5th day of January, 1960

My Commission Expires July 28, 1960

June Jewler
Notary Public.



15-193-19000-00-00

P

SCHUERMAN-EISENHOWER
SW SW Sec. 29-6S-32W
Thomas County, Kansas

ZINGELMEIER NO. 1

<u>From</u>	<u>To</u>	<u>Formation</u>	<u>Remarks</u>
0	40	Surface soil	
40	195	Sand	
195	220	Shale	Ran 9 jts. of 8-5/8" casing set at 218' with 160 sacks cement
220	400	Shale	
400	1575	Shale, sand & shells	
1575	1605	Shale and sand	
1605	1685	Dakota sand	
1685	1840	Shale & sand	
1840	2470	Shale & shells	
2470	2508	Lime & shale (Anhydrite #1)	
2508	2721	Shale & shells	
2721	2755	Anhydrite	
2755	2920	Shale & shells	
2920	3060	Red Bed, lime & shale	
3060	3734	Lime & shale	
3734	3945	Lime	
3945	4040	Lime & shale	
4040	4370	Lime	
4370	4430	Lime & shale	
4430	4530	Lime	
4530	4579	Lime & shale	
4579	4610	Lime	
4610	4650	Lime, shale & chert	
4650	4700	Lime	FD. Dry hole.

ST. ... COMMISSION
 JAN 7 1960
 CONSERVATION DIVISION
 Wichita, Kansas
 1-7-60

I certify the above to be a true and exact copy of the Driller's Log as shown by the Daily Drilling Reports.

BADGER DRILLERS, INC.

By J. C. Carver

Subscribed and sworn to before me this 4th day of January, 1960.

Doris M. Yocham
Doris M. Yocham, Notary Public

My commission expires 9-28-61