


15-193-20002 00-00

WELL PLUGGING RECORD

Give All Information Completely  
Make Required Affidavit  
Mail or Deliver Report to:  
Conservation Division  
State Corporation Commission  
212 No. Market  
Wichita, Kansas

NORTH

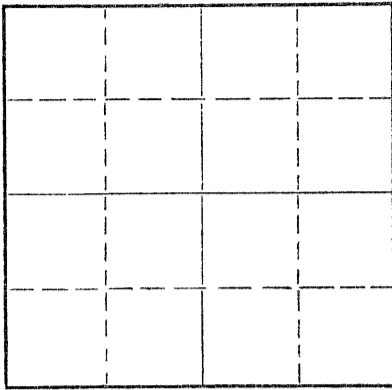

Locate well correctly on above  
Section Plat

Location as "NE/CNW%SW%" or footage from lines Thomas County. Sec. 15 Twp. 6 Rge. 32 (E) W (W)  
SE NW  
Lease Owner Leo J. Dreiling Oil Company  
Lease Name Zeberst Well No. 1  
Office Address Route 2, Victoria, Kansas 67671  
Character of Well (completed as Oil, Gas or Dry Hole) Dry Hole  
Date well completed 6-10 1968  
Application for plugging filed 6-10 1968  
Application for plugging approved 6-10 1968  
Plugging commenced 6-10 1968  
Plugging completed 6-10 1968  
Reason for abandonment of well or producing formation Dry Hole

If a producing well is abandoned, date of last production \_\_\_\_\_ 19\_\_\_\_  
Was permission obtained from the Conservation Division or its agents before plugging was commenced? Yes

Name of Conservation Agent who supervised plugging of this well Bill Nichols  
Producing formation \_\_\_\_\_ Depth to top \_\_\_\_\_ Bottom \_\_\_\_\_ Total Depth of Well \_\_\_\_\_ Feet  
Show depth and thickness of all water, oil and gas formations.

OIL, GAS OR WATER RECORDS

CASING RECORD

FORMATION	CONTENT	FROM	TO	SIZE	PUT IN	PULLED OUT
Surface Pipe				8 5/8"	258'	

Describe in detail the manner in which the well was plugged, indicating where the mud fluid was placed and the method or methods used in introducing it into the hole. If cement or other plugs were used, state the character of same and depth placed, from \_\_\_\_\_ feet to \_\_\_\_\_ feet for each plug set.

1st. plug was set at 1750' with 70 sacks cement 6% gel  
2nd. plug was set at 275' with 20 sacks cement 6% gel  
3rd. plug was set at 40' with 10 sacks cement 6% gel  
Cementing to bottom of cellar

RECEIVED  
STATE CORPORATION COMMISSION  
JUN 13 1968  
CONSERVATION DIVISION  
Wichita, Kansas

6/13-68

(If additional description is necessary, use BACK of this sheet)

Name of Plugging Contractor L. J. Dreiling & Sons, Inc.  
Address Route 2, Victoria, Kansas 67671

STATE OF KANSAS, COUNTY OF ELLIS, ss.  
I, Leo F. Dreiling (employee of owner) or (~~owner or operator~~) of the above-described well, being first duly sworn on oath, says: That I have knowledge of the facts, statements, and matters herein contained and the log of the above-described well as filed and that the same are true and correct. So help me God.

(Signature) Leo F. Dreiling  
LEO F. DREILING, ROUTE 2, VICTORIA, KANSAS 67671  
(Address)

SUBSCRIBED AND SWORN to before me this 12th day of June, 19 68

My commission expires September 19, 1970  
Joseph A. Hess  
JOSEPH A. HESS Notary Public.

