

15-163-20498-0000

STATE OF KANSAS
STATE CORPORATION COMMISSION

Form CP-4

WELL PLUGGING RECORD

Give All Information Completely
Make Required Affidavit
Mail or Deliver Report to:
Conservation Division
State Corporation Commission
212 No. Market
Wichita, Kansas 67202

Rooks County, Sec. 27 Twp. 7S Rge. (E) 16 (W)
Location as "NE/CNW/SW" or footage from lines NE/4 SW/4 SE/4
Lease Owner Petroleum Management, Inc.

Lease Name Hardman "A" Well No. 1
Office Address Box 1325, Great Bend, Kansas 67530

Character of Well (completed as Oil, Gas or Dry Hole)

Date well completed 19

Application for plugging filed 1-21 19 74

Application for plugging approved 1-28 19 74


Plugging commenced 4-1 19 74

Plugging completed 4-1 19 74

Reason for abandonment of well or producing formation

If a producing well is abandoned, date of last production 19

Was permission obtained from the Conservation Division or its agents before plugging was commenced?

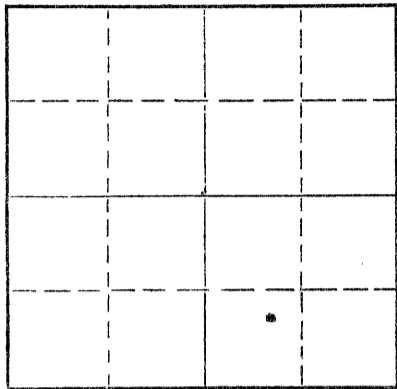

Locate well correctly on above Section Plat

Name of Conservation Agent who supervised plugging of this well Leo Massey

Producing formation Depth to top Bottom Total Depth of Well 3301 Feet

Show depth and thickness of all water, oil and gas formations.

OIL, GAS OR WATER RECORDS

CASING RECORD

FORMATION	CONTENT	FROM	TO	SIZE	PUT IN	PULLED OUT
				8 5/8	215'	
				4 1/2	2723'	2004'

Describe in detail the manner in which the well was plugged, indicating where the mud fluid was placed and the method or methods used in introducing it into the hole. If cement or other plugs were used, state the character of same and depth placed, from feet to feet for each plug set.

Plugged back with sand from TD to 2500'. Mixed and dumped 5 sx cement with bailer.

Squeezed down hole with 18 sx gel, 1 sk hulls, 70 sx cement, 8 sx gel, 1 sk hulls and 50 sx cement.

Gel 580' to 548'

Hulls 548' to 546'

Cement 546' to 230'

Gel 230' to 216'

Hulls 216' to 214'

Cement 214' to surface

RECEIVED
STATE CORPORATION COMMISSION

SEP 23 1974

CONSERVATION DIVISION
Wichita, Kansas

9-23-74

(If additional description is necessary, use BACK of this sheet)
Name of Plugging Contractor Midway Drilling, Inc. License #620
Address Box 921, Great Bend, Kansas 67530

STATE OF KANSAS, COUNTY OF SEDGWICK, ss.
DALE SILCOTT (employee of owner) or (owner or operator) of the above-described

well, being first duly sworn on oath, says: That I have knowledge of the facts, statements, and matters herein contained and the log of the above-described well as filed and that the same are true and correct. So help me God.

(Signature) Dale Silcott

(Address) _____, 19 74

SUBSCRIBED AND SWORN to before me this 20th day of September, 1974

MARIE C. MURPHY, Notary Public
My commission expires April 23, 1978

Notary Public.