

15-163-00217-00-00

STATE OF KANSAS
STATE CORPORATION COMMISSION


WELL PLUGGING RECORD

Give All Information Completely
Make Required Affidavit
Mail or Deliver Report to:
Conservation Division
State Corporation Commission
300 Bitting Building
Wichita, Kansas

OR
FORMATION PLUGGING RECORD

Strike out upper line
when reporting plug-
ging off formations.

ROOKS County. Sec. 28 Twp. 7S Rge. 16 W (W)
Location as "NE $\frac{1}{4}$ NW $\frac{1}{4}$ SW $\frac{1}{4}$ " or footage from lines SW SW NW
Lease Owner W.P. Faulkner & Pickrell Drilling Company, Inc.
Lease Name Fred E. Jones Well No. 1
Office Address 705 Fourth Natl Bank Bldg., Wichita, Kansas
Character of Well (completed as Oil, Gas or Dry Hole) Dry Hole
Date well completed 10/25 19 49
Application for plugging filed 10/24 19 49
Application for plugging approved 10/24 19 49
Plugging commenced 10/24 19 49
Plugging completed 10/25 19 49
Reason for abandonment of well or producing formation D. & A.

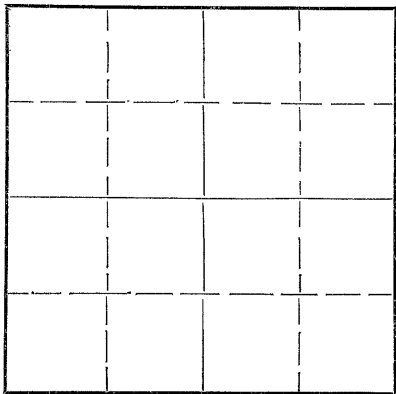

Locate well correctly on above
Section Plat

If a producing well is abandoned, date of last production 19
Was permission obtained from the Conservation Division or its agents before plugging was com-
menced? Yes

Name of Conservation Agent who supervised plugging of this well Eldon Petty
Producing formation Depth to top Bottom Total Depth of Well 3315 Feet
Show depth and thickness of all water, oil and gas formations.

OIL, GAS OR WATER RECORDS

CASING RECORD

Formation	Content	From	To	Size	Put In	Pulled Out
				8 5/8"	1080'	None
				No oil string run.		

Describe in detail the manner in which the well was plugged, indicating where the mud fluid was placed and the method or methods used in introducing it into the hole. If cement or other plugs were used, state the character of same and depth placed, from feet to feet for each plug set.

Filled hole with heavy mud from 3315 to 1080'. Set bridge and run 15 sacks cement. Fill with mud to 550' and bridge hole and run 15 sacks cement. Fill with mud to 30', bridge hole and run cement to bottom of cellar.

RECEIVED

Conservation Div.

NOV 7 1949 11-7-49

STATE CORPORATION
COMMISSION
KANSAS

(If additional description is necessary, use BACK of this sheet)

Correspondence regarding this well should be addressed to Pickrell Drilling Company, Inc.
Address 705 Fourth National Bank Building, Wichita 2, Kansas

STATE OF KANSAS, COUNTY OF SEDGWICK, ss.
C. W. SEBITS (employee of owner) or (owner or operator) of the above-described well,

being first duly sworn on oath, says: That I have knowledge of the facts, statements, and matters herein contained and the log of the above-described well as filed and that the same are true and correct. So help me God.

(Signature) *C. W. Sebits*

705 Fourth National Bank Bldg., Wichita, Ks.
(Address)

SUBSCRIBED AND SWORN to before me this 7th day of November, 19 49

Ethel Zimmerman
Notary Public.

My commission expires January 28, 1953.

PLUGGING
FILE SEC 28T 7 R 16W
BOOK PAGE 221 LINE 4

22-2625 2-48-15M

COMPANY: W. P. FAULKNER
 Wichita, Kansas Rotary Drilling Commenced: 10-13-49
 Rotary Drilling Completed: 10-25-1949

LOCATION: JONES #1, SW SW ^{NW} Sec. 28-78-16W
 Rooks County, Kansas

CONTRACTOR: PICKRELL DRILLING COMPANY, INC.
 Wichita, Kansas

CASING RECORD: 1080' (35 jts.) 8 5/8" 24# smls. casing set at 1080' in a 12 1/2" hole,
 cemented with 500 sacks bulk cement, Halliburton process.

Drilled 7 7/8" hole from 1080' to 3315' T.D. No oil string run.

LOG

(Figures indicate bottom formation - measurements from top rotary bushing.)

Shale & Shells	437	Circulate for samples at 2747'.
Sand, Shale & Shells	565	" " " " 3060'.
Sand & Iron	650	" " " " 3312'.
Sand, Shale & Shells	770	
Red Bed & Shells	945	
Shale & Shells	1076	
Anhydrite	1110	
Shale	1430	
Salt	1500	Slope test at 1500' - 0° off.
Shale & Red Bed	1580	" " " 2000' - 0° off.
Shale & Lime	1885	S.L.M. at 2500' O.K.
Lime	2000	Slope test at 2500' - 0° off.
Lime & Shale	2275	" " " 3000' - 0° off.
Shale	2305	
Shale & Shells	2490	
Shale	2732	
Lime	3275	
Lime & Shale	3305	
Lime	3315 Rotary T.D.	S.L.M. at 3315 O.K.

The undersigned, G. W. Sebitts, Secretary of PICKRELL DRILLING COMPANY, INC., hereby certifies in behalf of said corporation, that the above log is a true and correct log of the formation encountered in drilling the above well as reflected by the Daily Drilling Reports.

PICKRELL DRILLING COMPANY, INC.
 By G. W. Sebitts
 Secretary

STATE OF KANSAS)
) SS
 COUNTY OF SEDGWICK)

BE IT REMEMBERED that on this 31st day of October, 1949, before me, the undersigned, a Notary Public, duly commissioned, in and for the county and state aforesaid, came G. W. Sebitts, Secretary of Pickrell Drilling Company, Inc., a corporation of the State of Kansas, personally known to me to be such officer, and to be the same person who executed as such officer the foregoing instrument of writing in behalf of said corporation, and he duly acknowledged the execution of the same for himself and for said corporation.

IN WITNESS WHEREOF, I have hereunto set my hand and official seal on the day and year last above written.

My commission expires January 28, 1953.

PLUGGING
 FILE SEC 28 T 7 R 16W
 BOOK PAGE 121 LINE 12

Ethel Zimmerman
 Notary Public
RECEIVED
 Conservation Div
 NOV X 7 1949 11-7-49
 STATE CORPORATION
 COMMISSION
 KANSAS