


15-163-21098-00-00

STATE OF KANSAS
STATE CORPORATION COMMISSION

WELL PLUGGING RECORD

Give All Information Completely
Make Required Affidavit
Mail or Deliver Report to
Conservation Division
State Corporation Comm.
245 North Water
Wichita, KS 67202

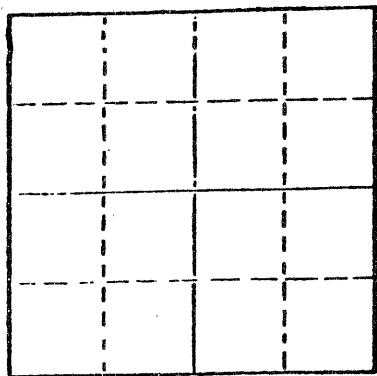

Locate well correctly on above
Section Plat

Rooks _____ County. Sec. 26 Twp. 7 Rge. 16 E/W
Location as "NE/CNW1/4SW1/4" or footage from lines _____
E/2 W/2 SW
Lease Owner Shields Oil Producers, Inc.
Lease Name Hardman Well No. 1
Office Address Shields Bldg., Russell, Kansas 67665
Character of Well (Completed as Oil, Gas or Dry Hole) _____
Dry hole
Date Well completed _____ 6-24 1980
Application for plugging filed _____ 6-24 1980
Application for plugging approved _____ 6-24 1980
Plugging commenced _____ 6-24 1980
Plugging completed _____ 6-24 1980
Reason for abandonment of well or producing formation _____

Dry hole
If a producing well is abandoned, date of last production _____ 19____
Was permission obtained from the Conservation Division or
its agents before plugging was commenced? Yes

Name of Conservation Agent who supervised plugging of this well Marion Schmidt
Producing formation _____ Depth to top _____ Bottom _____ Total Depth of Well 3,410'
Show depth and thickness of all water, oil and gas formations.

OIL, GAS OR WATER RECORDS

CASING RECORD

FORMATION	CONTENT	FROM	TO	SIZE	PUT IN	PULLED OUT
				8 5/8"	248'	Cmtd. w/175 sax

Describe in detail the manner in which the well was plugged, indicating where the mud fluid
was placed and the method or methods used in introducing it into the hold. If cement or other
plugs were used, state the character of same and depth placed, from _____ feet to
_____ feet for each plug set.

- Fill hole w/heavy mud
- Push bridge plug to 680'
- Pump 80 sax cement on plug thru 4 1/2" drill pipe
- Push bridge plug to 240'
- Pump 30 sax cement on plug thru 4 1/2" drill pipe
- Push bridge plug to 40' w/1/2 sax hulls on plug
- Dump 10 sax cement on plug to cellar
- Dump 5 sax cement in rat hole and mouse hole

(If additional description is necessary, use BACK of this sheet)
Name of Plugging Contractor Shields Drilling Co., Inc.

RECEIVED
STATE CORPORATION COMMISSION
JUL 9 1980
CONSERVATION DIVISION
Wichita, Kansas

STATE OF KANSAS COUNTY OF RUSSELL, ss. R.L. SHIELDS (~~employee of owner~~) or (owner or operator)
of the above-described well, being first duly sworn on oath, says: That I have knowledge of
the facts, statements, and matters herein contained and the log of the above-described well
as filed and that the same are true and correct. So help me God.

(Signature) R.L. Shields
Shields Bldg., Russell, Kansas
(Address)

SUBSCRIBED AND SWORN TO before me this 1st day of July, 1980

Ruth Phillips
Notary Public.

My commission expires

