

15-163-20560-00-00

STATE OF KANSAS
STATE CORPORATION COMMISSION

Form CP-4

Give All Information Completely
Make Required Affidavit
Mail or Deliver Report to:
Conservation Division
State Corporation Commission

WELL PLUGGING RECORD

P. O. Box 17027
Wichita, Kansas 67217
NORTH

ROOKS County. Sec. 10 Twp. 7S Rge. ~~X4E~~ 16(W)

Location as "NE/CNW/SW" or footage from lines. C, NW 1/4 SW 1/4 SE 1/4

Lease Owner Henry H. Gungoll Associates

Lease Name MUIR UNIT Well No. 1

Office Address P. O. Box 1422, Enid, Oklahoma 73701

Character of Well (completed as Oil, Gas or Dry Hole) DRY HOLE

Date well completed February 8 19 75


Application for plugging filed February 7 19 75

Application for plugging approved Verbal-Mr. Leo Massey Feb. 7 19 75

Plugging commenced February 8 19 75

Plugging completed February 8 19 75

Reason for abandonment of well or producing formation DRY HOLE

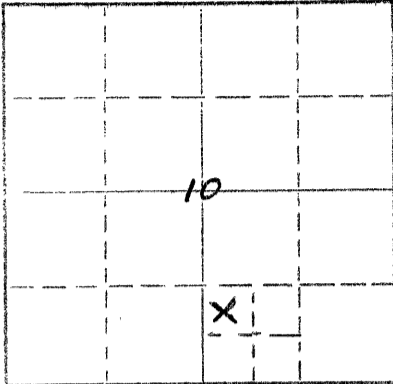

Locate well correctly on above Section Plat

If a producing well is abandoned, date of last production - - - - - 19 - - -

Was permission obtained from the Conservation Division or its agents before plugging was commenced? Yes, Mr. Leo Massey of Hays, Kansas

Name of Conservation Agent who supervised plugging of this well Mr. Leo Massey

Producing formation _____ Depth to top _____ Bottom _____ Total Depth of Well _____ Feet

Show depth and thickness of all water, oil and gas formations.

OIL, GAS OR WATER RECORDS

CASING RECORD

FORMATION	CONTENT	FROM	TO	SIZE	PUT IN	PULLED OUT
				8-5/8"	1020'	None

Describe in detail the manner in which the well was plugged, indicating where the mud fluid was placed and the method or methods used in introducing it into the hole. If cement or other plugs were used, state the character of same and depth placed, from _____ feet to _____ feet for each plug set.

Used 45 sacks of Regular (50/50) Posmix "A" with 4% Gel added.
Spotted 1st plug of 8 bbls. of slurry 400' from top back up the hole,
spotted 2nd plug of 2.5 bbls. slurry - followed by 8 1/2 5/8" plug.

RECEIVED
STATE CORPORATION COMMISSION

FEB 12 1975

2-12-75

CONSERVATION DIVISION
Wichita, Kansas

(If additional description is necessary, use BACK of this sheet)

Name of Plugging Contractor Red Tiger Drilling Co.

Address 1720 Wichita Plaza, Wichita, Kansas 67202

STATE OF Oklahoma COUNTY OF Garfield, ss.

Richard J. Lawson, Petroleum Engineer (employee of owner) or (~~owner~~) of the above-described

well, being first duly sworn on oath, says: That I have knowledge of the facts, statements, and matters herein contained and the log of the above-described well as filed and that the same are true and correct. So help me God.

(Signature) Richard J. Lawson

Richard J. Lawson, Petroleum Engineer
Henry H. Gungoll Associates
P. O. Box 1422, Enid, Oklahoma 73701

SUBSCRIBED AND SWORN to before me this 11th day of February, 19 75

My commission expires July 24, 1976

Desdive Ann Milacek
Desdive Ann Milacek Notary Public.