

15-163-21071-00-00


STATE OF KANSAS  
STATE CORPORATION COMMISSION

WELL PLUGGING RECORD

Give All Information Completely  
Make Required Affidavit  
Mail or Deliver Report to  
Conservation Division  
State Corporation Comm.  
245 North Water  
Wichita, KS 67202

ROOKS County. Sec. 19 Twp. 7S Rge. 16 E/W  
Location as "NE/CNW $\frac{1}{4}$ SW $\frac{1}{4}$ " or footage from lines NE-NE-NE

Lease Owner JAY A BAKER  
Lease Name SARVER Well No. 1  
Office Address Box 10, Codell, KS 67630  
Character of Well (Completed as Oil, Gas or Dry Hole) Oil Well

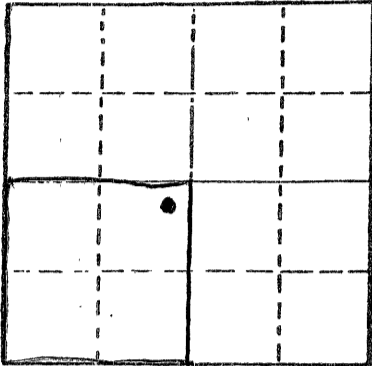

Locate well correctly on above  
Section Plat

Date Well completed 5/22/1980  
Application for plugging filed 12/8/1981  
Application for plugging approved 12/8/1981  
Plugging commenced 12/9/1981  
Plugging completed 12/9/1981  
Reason for abandonment of well or producing formation Formation dried up

If a producing well is abandoned, date of last production 10/10/1981

Was permission obtained from the Conservation Division or its agents before plugging was commenced? yes

Name of Conservation Agent who supervised plugging of this well Marion Schmidt  
Producing formation Topeka Depth to top 2628 Bottom 2791 Total Depth of Well 3250  
Show depth and thickness of all water, oil and gas formations.

OIL, GAS OR WATER RECORDS

CASING RECORD

FORMATION	CONTENT	FROM	TO	SIZE	PUT IN	PULLED OUT
Topeka		2628	2791	4 1/2	3109	2000
Heebner		2816				
Toronto		2839				
Lansing-KC		2859				
BKC						

Describe in detail the manner in which the well was plugged, indicating where the mud fluid was placed and the method or methods used in introducing it into the hold. If cement or other plugs were used, state the character of same and depth placed, from \_\_\_\_\_ feet to \_\_\_\_\_ feet for each plug set. Mixed 4 sks hulls, 12 sks gel, 1 sk hulls, 70 sks cement, 5 sks gel, released plug & mixed 70 sks cement

(If additional description is necessary, use BACK of this sheet)

Name of Plugging Contractor Allied Cementing Co. Inc.

STATE OF Kansas COUNTY OF Rooks, ss.  
Jay A Baker (employee of owner) or (owner or operator)  
of the above-described well, being first duly sworn on oath, says: That I have knowledge of the facts, statements, and matters herein contained and the log of the above-described well as filed and that the same are true and correct. So help me God.


(Signature) Jay A Baker

Box 10 Codell, KS 67630  
(Address)

SUBSCRIBED AND SWORN TO before me this 24th day of December, 1981

Connie Jo Austin  
Notary Public.

My commission expires

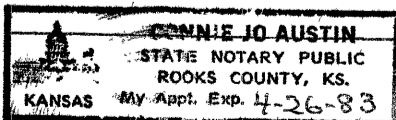

RECEIVED  
STATE CORPORATION COMMISSION  
1-5-82  
JAN-5 1982

CONSERVATION DIVISION  
Wichita Kansas