

CARD MUST BE TYPED

State of Kansas
NOTICE OF INTENTION TO DRILL
(see rules on reverse side)

CARD MUST BE SIGNED

Starting Date: January 12, 1985
month day year

API Number 15- 163-22,606 0000

OPERATOR: License # 9826
Name Scarth Oil & Gas Co.
Address 901 S. Polk
City/State/Zip Amarillo, TX 79101
Contact Person T. S. Clopton
Phone (806) 373-6932

.NW. .SW. .SW Sec .3. Twp .7. S, Rge .20. East
(location) West

CONTRACTOR: License # 5422
Name Abercrombie Drilling, Inc.
City/State Wichita, Kansas

990..... Ft North from Southeast Corner of Section
4950..... Ft West from Southeast Corner of Section
(Note: Locate well on Section Plat on reverse side)

Nearest lease or unit boundary line 330 feet.
County Rooks
Lease Name Ross Well# 4

Well Drilled For: Well Class: Type Equipment:
 Oil Swd Infield Mud Rotary
 Gas Inj Pool Ext. Air Rotary
 OWWO Expl Wildcat Cable

Domestic well within 330 feet: yes no
Municipal well within one mile: yes no

Depth to Bottom of fresh water 200 feet
Lowest usable water formation Dakota
Depth to Bottom of usable water 1100 feet
Surface pipe by Alternate: 1 2
Surface pipe to be set 325 feet
Conductor pipe if any required 77 feet
Ground surface elevation 2113 feet MSL

If OWWO: old well info as follows:
Operator
Well Name
Comp Date Old Total Depth
Projected Total Depth feet
Projected Formation at TD
Expected Producing Formations

This Authorization Expires 7-2-85
Approved By R.H. / KCC 1-2-85

I certify that we will comply with K.S.A. 55-101, et seq., plus eventually plugging hole to K.C.C. specifications.

Date 12-26-84 Signature of Operator or Agent T. S. Clopton


T. S. Clopton
Title Mgr. of Opns.

mhc/KOHE 1/2/85 Form C-1 4/84

**Must be filed with the K.C.C. five (5) days prior to commencing well
This card void if drilling not started within six (6) months of date received by K.C.C.**

Important procedures to follow :

**A Regular Section of Land
1 Mile = 5,280 Ft.**

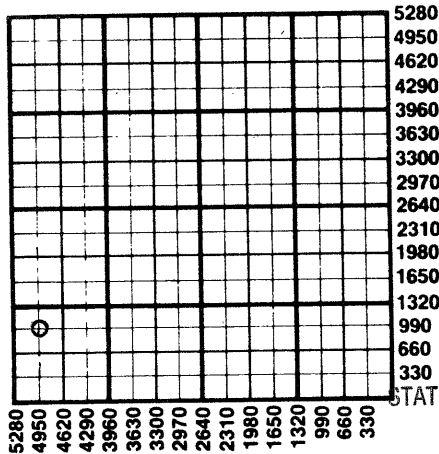

1. Notify District office before setting surface casing.
2. Set surface casing by circulating cement to the top.
3. File completion forms ACO-1 with K.C.C. within 90 days of well completion, following instructions on ACO-1, side 1, and including copies of wireline logs.
4. Notify District office 48 hours prior to old well workover or re-entry.
5. Prior to plugging, prepare a plugging plan, then obtain agreement from the appropriate district office for an approved plugging plan.
6. Submit plugging report (CP-4) to K.C.C. after plugging is completed.
7. Obtain an approved injection docket number before disposing of salt water.
8. Notify K.C.C. within 10 days when injection commences or terminates.

9. If an alternate 2 completion, cement in the production pipe from below any usable water to surface within 120 days of spud date.

RECEIVED
STATE CORPORATION COMMISSION

JAN 02 1985
1/2/85
CONSERVATION DIVISION
Wichita, Kansas

State Corporation Commission of Kansas
Conservation Division
200 Colorado Derby Building
Wichita, Kansas 67202
(316) 263-3238