

CARD MUST BE TYPED

State of Kansas
NOTICE OF INTENTION TO DRILL
(see rules on reverse side)

CARD MUST BE SIGNED

Starting Date:9.....30.....85.....
month day year

API Number 15- 163-22,7670000

OPERATOR: License # 9123
Name Diamond Shamrock Exploration Company
Address P. O. Box 400
City/State/Zip Amarillo, Texas 79188-0001
Contact Person James Skees
Phone 806/378-5681

SE NW SE Sec 3 Twp 7 S, Rge 20 East
(location) West

.....1650..... Ft North from Southeast Corner of Section
.....1650..... Ft West from Southeast Corner of Section
(Note: Locate well on Section Plat on reverse side)

CONTRACTOR: License #
Name Not available at this time
City/State

Nearest lease or unit boundary line1650..... feet.
County Rooks

Lease Name Sandra K. Gottschalk. Well#8.....

Well Drilled For: Well Class: Type Equipment:
 Oil Swd Infield Mud Rotary
 Gas Inj Pool Ext. Air Rotary
 OWWO Expl Wildcat Cable

Domestic well within 330 feet: yes no
Municipal well within one mile: yes no

Depth to Bottom of fresh water160..... feet
Lowest usable water formationDakota.....
Depth to Bottom of usable water~1000..... feet
Surface pipe by Alternate: 1 2
Surface pipe to be set300..... feet
Conductor pipe if any required feet
Ground surface elevation2163'..... feet MSL

If OWWO: old well info as follows:
Operator
Well Name
Comp Date Old Total Depth
Projected Total Depth3650..... feet
Projected Formation at TD Lansing
Expected Producing Formations Lansing/Arbuckle

This Authorization Expires3-16-86.....
Approved By7-16-85.....
Pat Jones

I certify that we will comply with K.S.A. 55-101, et seq., plus eventually plugging hole to K.C.C. specifications.

Date 9-12-85 Signature of Operator or Agent *Pat Jones*
Patti Jones

Title Drlg. & Prod. Clerk


Must be filed with the K.C.C. five (5) days prior to commencing well
 This card void if drilling not started within six (6) months of date received by K.C.C.

RECEIVED
 STATE CORPORATION COMMISSION
 9/16/85

A Regular Section of Land
 1 Mile = 5,280 Ft.

SEP 16 1985

CONSERVATION DIVISION
 Wichita, Kansas

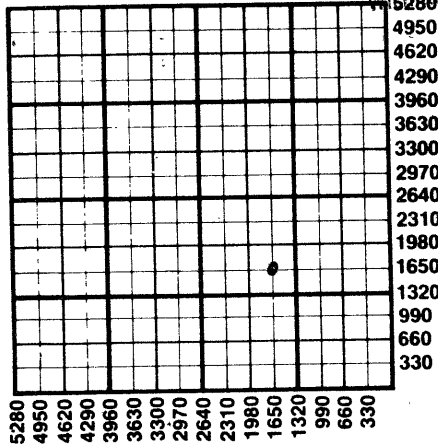

Important procedures to follow :

1. Notify District office before setting surface casing.
2. Set surface casing by circulating cement to the top.
3. File completion forms ACO-1 with K.C.C. within 90 days of well completion, following instructions on ACO-1, side 1, and including copies of wireline logs.
4. Notify District office 48 hours prior to old well workover or re-entry.
5. Prior to plugging, prepare a plugging plan, then obtain agreement from the appropriate district office for an approved plugging plan.
6. Submit plugging report (CP-4) to K.C.C. after plugging is completed.
7. Obtain an approved injection docket number before disposing of salt water.
8. Notify K.C.C. within 10 days when injection commences or terminates.
9. If an alternate 2 completion, cement in the production pipe from below any usable water to surface within 120 days of spud date.

State Corporation Commission of Kansas
 Conservation Division
 200 Colorado Derby Building
 Wichita, Kansas 67202
 (316) 263-3238