


15-179-00016-20-00

WELL PLUGGING RECORD

Give All Information Completely
Make Required Affidavit
Mail or Deliver Report to:
Conservation Division
State Corporation Commission
800 Bitting Building
Wichita, Kansas

NORTH

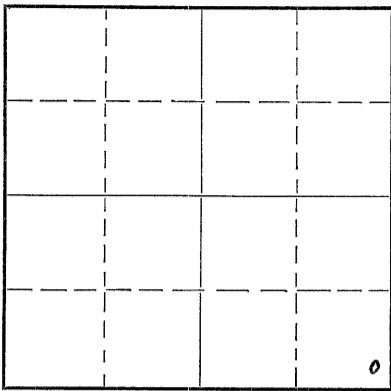

Locate well correctly on above
Section Plat

Sheridan County, Sec. 36 Twp. 6 Rge. (E) 27 (W)
Location as "NE/CNW 1/4 SW 1/4" or footage from lines SE 1/4 SE 1/4 SE 1/4
Lease Owner Musgrove Petroleum Corporation
Lease Name Sidesinger Well No. 1
Office Address 407 K.F.H. Building, Wichita 2, Kansas
Character of Well (completed as Oil, Gas or Dry Hole) Dry Hole
Date well completed 9-7 19 50
Application for plugging filed (Oral) 9-7 19 50
Application for plugging approved 9-7 19 50
Plugging commenced 9-7 19 50
Plugging completed 9-7 19 50
Reason for abandonment of well or producing formation Dry

If a producing well is abandoned, date of last production 19
Was permission obtained from the Conservation Division or its agents before plugging was commenced? Yes

Name of Conservation Agent who supervised plugging of this well Mr. Petty, Hays, Kansas
Producing formation Depth to top Bottom Total Depth of Well 438 Feet
Show depth and thickness of all water, oil and gas formations.

OIL, GAS OR WATER RECORDS

CASING RECORD

Formation	Content	From	To	Size	Put In	Pulled Out
				8-5/8"	155'	None

Describe in detail the manner in which the well was plugged, indicating where the mud fluid was placed and the method or methods used in introducing it into the hole. If cement or other plugs were used, state the character of same and depth placed, from feet to feet for each plug set.

Filled hole full heavy mud to 155' of top. Drove wooden plug to 155' and dumped in 15 sacks cement. Finished filling hole with heavy mud to within 35' of cellar and put in 10 sacks cement.

RECEIVED
STATE CORPORATION COMMISSION
09-23-1950
SEP 23 1950
CONSERVATION DIVISION
Wichita, Kansas

(If additional description is necessary, use BACK of this sheet)
Correspondence regarding this well should be addressed to Musgrove Petroleum Corp.
Address 407 K.F.H. Bldg. Wichita, Kansas
Wichita 2, Kansas

STATE OF KANSAS, COUNTY OF SEDGWICK, ss.
GORDON L. KOELLING (employee of owner) or (owner or operator) of the above-described well,
being first duly sworn on oath, says: That I have knowledge of the facts, statements, and matters herein contained and the log of the above-described well as filed and that the same are true and correct. So help me God.

(Signature) Gordon L. Koelling
(Address)

SUBSCRIBED AND SWORN to before me this 22nd day of September, 19 50
Madin J. Jirrel
Notary Public.

My commission expires December 5, 1951

PLUGGING
FILE SEC 36 T 6 R 27 W
BOOK PAGE 26 LINE 29