


15-179-00013-00-00

PLUGGING RECORD

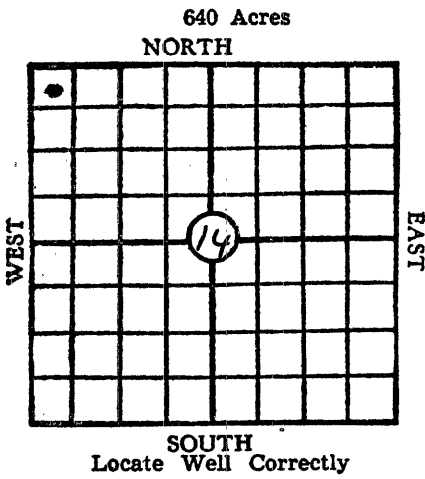

Mail To
 Kansas ~~OKLAHOMA~~ CORPORATION COMMISSION
 Oil and Gas Conservation Department
~~OKLAHOMA CITY, OKLAHOMA~~
 Wichita, Kansas

NOTICE: All questions on this form must be satisfactorily answered.

Company Operating Sterling Drilling Company
 Office Address Sterling, Kansas
 County Sheridan Sec. 14 Twp. 6 Range 27W
 Location in Section NW $\frac{1}{4}$ NW $\frac{1}{4}$ NW $\frac{1}{4}$
 Farm Name Fulton Well No. #1 Field WC
 Character of Well (whether oil, gas or dry) Dry

Commenced Plugging July 13 Finished July 13-45 Total Depth 4431

Was permission obtained from the Corporation Commission or its agents before plugging was commenced yes

Name of Conservation Officer who supervised plugging of this well Herb Kerr

Name of producing sand ----- Depth top -----, Bottom 4431

Show depth and thickness of all fresh water, oil and gas formations.


SAND OR ZONE RECORDS

CASING RECORDS

Formation	Content	From	To	Size	Put In	Put In
Shale & Shells		0	2300	10 3/4"	240'	Surface pipe
Anhydrite		2300	2316			
Shale & Shells		2316	3680			
KC		3680	3905			
Lime & Shale		3905	4370			
Conglomerate		4370	4420			
Miss Lime		4420	4431			

Describe in detail the manner in which the well was plugged, indicating where the mud fluid was placed and the methods used in introducing it into the hole. If cement or other plugs were used, state the character of same and depth placed:


Plugged with 20 sacks cement at 230 feet through drill pipe, 10 sacks cement at top.

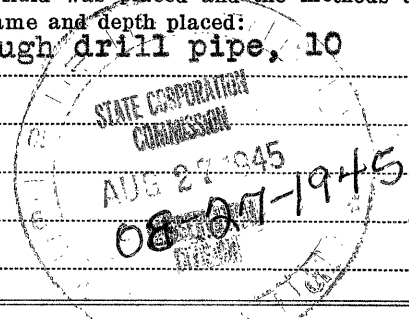

Does the above conform strictly to the oil and gas regulations? yes

The Law requires that adjacent lease, royalty and land-owners be notified; give their names with their addresses below:

Wildcat

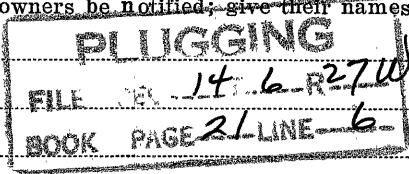

REMARKS: Why plugged? dry If abandoned oil or gas well, state amount and date of last production None

Correspondence regarding this well should be addressed to Sterling Drilling Company

Address Sterling, Kansas

I, the undersigned, being first duly sworn upon oath, state that this well record is true, correct and complete according to the records of this office and to the best of my knowledge and belief.

H. A. Wellen
 Name and title of representative of company

Subscribed and sworn to before me this 24th day of August, 1945

My Commission expires April 19, 1947

Phis E. Beck
 Notary Public