


STATE OF KANSAS
STATE CORPORATION COMMISSION

Give All Information Completely
Make Required Affidavit
Mail or Deliver Report to:
Conservation Division
State Corporation Commission
212 No. Market
Wichita, Kansas

15-179-05153-00-00 Form CP-4

WELL PLUGGING RECORD

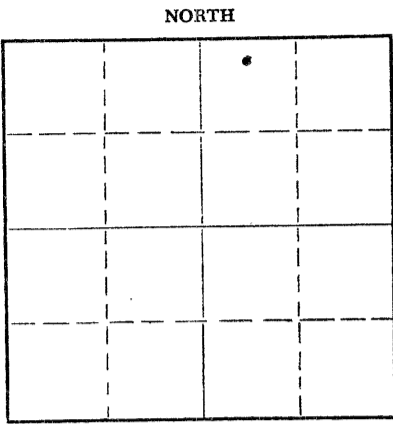

Locate well correctly on above Section Plat

Sheridan County, Sec. 13 Twp. 6S Rge. (E) 27(W)
Location as "NE/CNW/SW" or footage from lines 330' FNL 1980' FEL
Lease Owner CITIES SERVICE OIL COMPANY
Lease Name Adell Unit Well No. 404W
Office Address Box 553 Russell, Kansas
Character of Well (completed as Oil, Gas or Dry Hole) Oil
Date well completed 9-26 19 58
Application for plugging filed 9-20 19 68
Application for plugging approved 9-23 19 68
Plugging commenced 10-14 19 68
Plugging completed 10-14 19 68
Reason for abandonment of well or producing formation Non-economical casing bad
If a producing well is abandoned, date of last production August 14 1968
Was permission obtained from the Conservation Division or its agents before plugging was commenced? Yes

Name of Conservation Agent who supervised plugging of this well Mr. W. L. Nichols Morland, Kansas
Producing formation Lansing Kansas City Depth to top 3633' Bottom 3716' Total Depth of Well 3775 Feet
Show depth and thickness of all water, oil and gas formations.

OIL, GAS OR WATER RECORDS

CASING RECORD

FORMATION	CONTENT	FROM	TO	SIZE	PUT IN	PULLED OUT
				8 5/8"	217'	None
				5 1/2"	3775'	None

Describe in detail the manner in which the well was plugged, indicating where the mud fluid was placed and the method or methods used in introducing it into the hole. If cement or other plugs were used, state the character of same and depth placed, from _____ feet to _____ feet for each plug set.

Ran 122 Jts. 2" tubing to bottom open end. Displaced 20 Sx. 50/50 Pozmix cement plus 6% Gel from 3722'-3562'. Pulled tbg. to 3510'. Circulated and displaced 25 Sx. Gell. Pulled tbg. to 1280'. Circulated and displaced 40 Sx. cement 1280' to 960'. Pulled tubing to 240'. Circulated and displaced 10 Sx. cement 240' to 160'. Pulled tbg. to 30'. Circulated and displaced 5 Sx. cement 30' to surface. Cut off casing and capped end.

RECEIVED
OCT 21 1968
STATE CORPORATION COMMISSION
CONSERVATION DIVISION
Wichita, Kansas
10-21-1968

(If additional description is necessary, use BACK of this sheet)

Name of Plugging Contractor Halliburton Co.
Address Hays, Kansas

STATE OF Kansas, COUNTY OF Russell, ss.
E. W. Peterman (employee of owner) or (owner or operator) of the above-described well, being first duly sworn on oath, says: That I have knowledge of the facts, statements, and matters herein contained and the log of the above-described well as filed and that the same are true and correct. So help me God.

(Signature) E. W. Peterman Operations Supt.
Box 553 Russell, Kansas 67665
(Address)

17th day of October, 19 68

October 5, 1972

James F. Kyger James F. Kyger
Notary Public.

