


STATE OF KANSAS  
 STATE CORPORATION COMMISSION

Give All Information Completely  
 Make Required Affidavit  
 Mail or Deliver Report to:  
 Conservation Division  
 State Corporation Commission  
 800 Biting Building  
 Wichita, Kansas

OR  
**FORMATION PLUGGING RECORD** Strike out upper line when reporting plugging off formations.

Sheridan County. Sec. 13 Twp. 6 Rge. 27 (X) (W)  
 Location as "NE $\frac{1}{4}$ NW $\frac{1}{4}$ SW $\frac{1}{4}$ " or footage from lines NW NE NW  
 Lease Owner Shields Oil Producers  
 Lease Name Muir Well No. 1  
 Office Address 830 Main - Russell, Kansas  
 Character of Well (completed as Oil, Gas or Dry Hole) Dry hole  
 Date well completed August 3 19 52  
 Application for plugging filed August 3 19 52  
 Application for plugging approved August 3 19 52  
 Plugging commenced August 3 19 52  
 Plugging completed August 3 19 52  
 Reason for abandonment of well or producing formation Dry hole

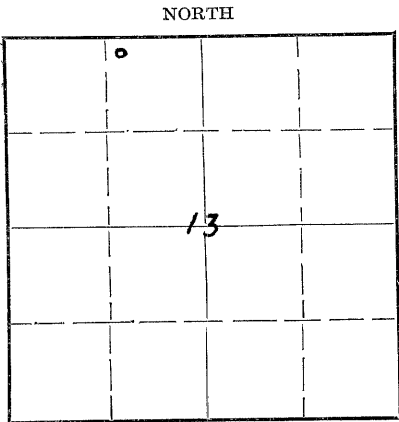

Locate well correctly on above Section Plat

If a producing well is abandoned, date of last production not producing 19       
 Was permission obtained from the Conservation Division or its agents before plugging was commenced? Yes

Name of Conservation Agent who supervised plugging of this well Eldon Petty - Hays, Kansas  
 Producing formation none Depth to top      Bottom      Total Depth of Well 4010' Feet  
 Show depth and thickness of all water, oil and gas formations.


OIL, GAS OR WATER RECORDS

CASING RECORD

Formation	Content	From	To	Size	Put In	Pulled Out
Topeka Lime	No show	3491	3688	8 5/8"	243'	Cemented 200 sax
Heebner Shale	No show	3696	3699			
Toronto Lime	No show	3718	3736			
Kansas City Lime	No show	3736	3954			
Marmaton	No show	3954	4010			

Describe in detail the manner in which the well was plugged, indicating where the mud fluid was placed and the method or methods used in introducing it into the hole. If cement or other plugs were used, state the character of same and depth placed, from      feet to      feet for each plug set.

Total Depth 4010' R. B.  
 Heavy Mud to 240'  
 1/2 sack Hulls 240'  
 15 sax cement on 8 5/8" Halliburton plug  
 Heavy mud from Top of Cement XX to 40'  
 1/2 sack Hulls and 10 sacks cement @ 40' on 8 5/8" Halliburton plu  
 Cemented from Halliburton plug to surface.  
 (243' of 8 5/8" casing cemented in)

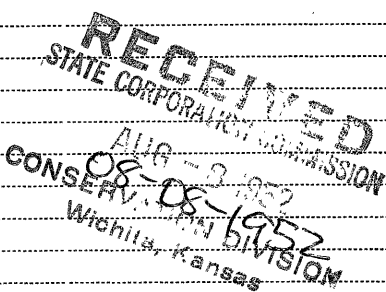

(If additional description is necessary, use BACK of this sheet)

Correspondence regarding this well should be addressed to Shields Oil Producers  
 Address Box 248  
Russell, Kansas

STATE OF Kansas, COUNTY OF Russell, ss.  
I, Robert J. Shields (operator or owner) of the above-described well, being first duly sworn on oath, says: That I have knowledge of the facts, statements, and matters herein contained and the log of the above-described well as filed and that the same are true and correct. So help me God.

(Signature) Robert J. Shields  
Box 248 - Russell, Kansas (Address)

SUBSCRIBED AND SWORN to before me this 6<sup>th</sup> day of August, 19 52  
     Notary Public.

My commission expires May 7, 1956  
 22-2625 2-48-15M

