


Give All Information Completely
Make Required Affidavit
Mail or Deliver Report to:
Conservation Division
State Corporation Commission
212 No. Market
Wichita, Kansas

WELL PLUGGING RECORD

NORTH

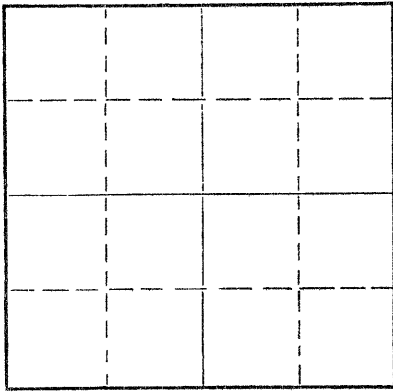

Locate well correctly on above
Section Plat

Sheridan County. Sec. 28 Twp. 6 Rge. (E) 27 (W)
Location as "NE/CNW/SW" or footage from lines C SW NW
Lease Owner Woodman & Iannitti Drilling Co.
Lease Name Coulter Well No. 1
Office Address 706 Union Nat'l. Bldg.
Character of Well (completed as Oil, Gas or Dry Hole) Dry Hole
Date well completed April 29 19 68
Application for plugging filed April 29 19 68
Application for plugging approved April 29 19 68
Plugging commenced April 29 19 68
Plugging completed April 29 19 68
Reason for abandonment of well or producing formation Dry

If a producing well is abandoned, date of last production 19
Was permission obtained from the Conservation Division or its agents before plugging was commenced? Yes

Name of Conservation Agent who supervised plugging of this well W. L. Nichols
Producing formation _____ Depth to top _____ Bottom _____ Total Depth of Well 4150 Feet
Show depth and thickness of all water, oil and gas formations.

OIL, GAS OR WATER RECORDS

CASING RECORD

FORMATION	CONTENT	FROM	TO	SIZE	PUT IN	PULLED OUT
				8 5/8	328'	
<p>RECEIVED STATE CORPORATION COMMISSION APR 30 1968 CONSERVATION DIVISION Wichita, Kansas 04-30-1968</p>						


Describe in detail the manner in which the well was plugged, indicating where the mud fluid was placed and the method or methods used in introducing it into the hole. If cement or other plugs were used, state the character of same and depth placed, from _____ feet to _____ feet for each plug set.

Bottom Plug @ 1530' with 100 sx
Middle Plug @ 360' with 20 sx
Top Plug @ 40' with 10 sx

(If additional description is necessary, use BACK of this sheet)

Name of Plugging Contractor _____
Address _____

STATE OF KANSAS, COUNTY OF SEDGWICK, ss.
K. T. WOODMAN (employee of owner) or (owner or operator) of the above-described well being first duly sworn on oath, says: That I have knowledge of the facts, statements, and matters herein contained and the log of the above-described well as filed and that the same are true and correct. So help me God.

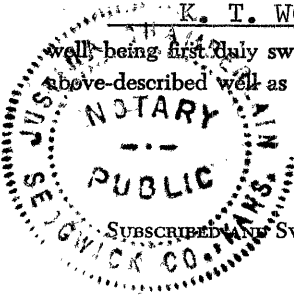

(Signature) K. T. Woodman
706 Union Nat'l. Bldg.
(Address)

SUBSCRIBED AND SWORN TO before me this 30th day of April, 19 68

My commission expires Feb. 11, 1972
Justina Chamberlain Notary Public.