


WELL PLUGGING RECORD

Give All Information Completely
Make Required Affidavit
Mail or Deliver Report to:
Conservation Division
State Corporation Commission
211 No. Broadway
Wichita, Kansas

Sheridan County, Sec. 26 Twp. 6 Rge. 27 (E) (W) ^x

Location as "NE/CNW/SW" or footage from lines SW SW SW
Lease Owner Empire Drilling Company
Lease Name Dutton Well No. 1
Office Address 650 Fourth National Bank Building, Wichita 2, Kansas
Character of Well (completed as Oil, Gas or Dry Hole) Dry Hole
Date well completed June 17, 1959 19
Application for plugging filed June 17, 1959 19
Application for plugging approved June 17, 1959 19
Plugging commenced June 17, 1959 19
Plugging completed June 17, 1959 19
Reason for abandonment of well or producing formation Dry Hole

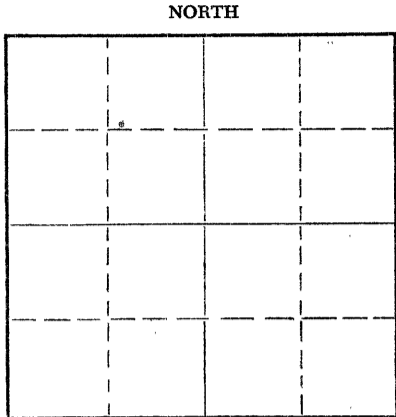

Locate well correctly on above Section Plat

If a producing well is abandoned, date of last production _____ 19____
Was permission obtained from the Conservation Division or its agents before plugging was commenced? Yes

Name of Conservation Agent who supervised plugging of this well A. D. Fabricius
Producing formation _____ Depth to top _____ Bottom _____ Total Depth of Well 4125 Feet
Show depth and thickness of all water, oil and gas formations.

OIL, GAS OR WATER RECORDS

CASING RECORD

FORMATION	CONTENT	FROM	TO	SIZE	PUT IN	PULLED OUT
	Surface	0	309	8 5/8"	309'	

Describe in detail the manner in which the well was plugged, indicating where the mud fluid was placed and the method or methods used in introducing it into the hole. If cement or other plugs were used, state the character of same and depth placed, from _____ feet to _____ feet for each plug set.

Plug set at 500' w/ 20 sx cement
Plug set at 310' w/ 20 sx cement
Plug set at 40' w/ 10 sx cement

RECEIVED
STATE CORPORATION COMMISSION

JUN 26 1959
06-26-1959
CONSERV
Wich

(If additional description is necessary, use BACK of this sheet)
Name of Plugging Contractor Empire Drilling Company
Address 650 Fourth National Bank Building, Wichita 2, Kansas

STATE OF KANSAS, COUNTY OF SEDGWICK, ss.
Dan J. Kornfeld ~~XXXXXX~~ (owner or operator) of the above-described well, being first duly sworn on oath, says: That I have knowledge of the facts, statements, and matters herein contained and the log of the above-described well as filed and that the same are true and correct. So help me God.

(Signature) [Signature]
650 Fourth National Bank Bldg, Wichita 2, Ks.
(Address)

SUBSCRIBED AND SWORN TO before me this 25th day of June, 19 59

My commission expires October 21, 1962

Lucille H. Harr
Lucille H. Harr Notary Public.

PLUGGING
FILE SEC. 26 T. 6 R. 27 W. 4
BOOK PAGE 60 LINE 43