

CARD MUST BE TYPED

State of Kansas
NOTICE OF INTENTION TO DRILL
(see rules on reverse side)

CARD MUST BE SIGNED

Starting Date: .. March 10, 1985.....
month day year

API Number 15- 163-22,646-00-00

OPERATOR: License # .. 6111

SW SE SW Sec 13. Twp 7.. S, Rge 20. East
(location) West

Name ... N-B. Company, Inc.

Address .. P. O. Box 506

City/State/Zip .. Russell, Kansas 67665

Contact Person .. Joe K. Branum

Phone ... (913)-483-3518

330 Ft North from Southeast Corner of Section

3630 Ft West from Southeast Corner of Section

(Note: Locate well on Section Plat on reverse side)

CONTRACTOR: License # .. 8241

Name .. Emphasis Oil Operations

City/State P.O. Box 506, Russell, KS...67665-0506

Nearest lease or unit boundary line 330 feet.

County ... Rooks

Lease Name .. Schneider

Well# .. 2

Domestic well within 330 feet : yes no

Municipal well within one mile : yes no

Well Drilled For: Well Class: Type Equipment:

Oil Swd Infield Mud Rotary

Gas Inj Pool Ext. Air Rotary

OWWO Expl Wildcat Cable

If OWWO: old well info as follows:

Operator

Well Name

Comp Date Old Total Depth

Projected Total Depth 3625 feet

Projected Formation at TD Arbuckle

Expected Producing Formations .. Arbuckle & Lansing

1960
Depth to Bottom of fresh water 75 feet

Lowest usable water formation Dakota

Depth to Bottom of usable water 950 feet

Surface pipe by Alternate : 1 2

Surface pipe to be set 220 feet

Conductor pipe if any required

Ground surface elevation .. Est. Elev. 2030 feet MSL

This Authorization Expires 9-6-85

Approved By 3-6-85 RC

I certify that we will comply with K.S.A. 55-101, et seq., plus eventually plugging hole to K.C.C. specifications.

Date .. 3-5-85 Signature of Operator or Agent

Joe K. Branum

Title .. President


Form C-1 4/84

MHC/KOHE 3-6-85

**Must be filed with the K.C.C. five (5) days prior to commencing well
This card void if drilling not started within six (6) months of date received by K.C.C.**

Important procedures to follow:

**A Regular Section of Land
1 Mile = 5,280 Ft.**

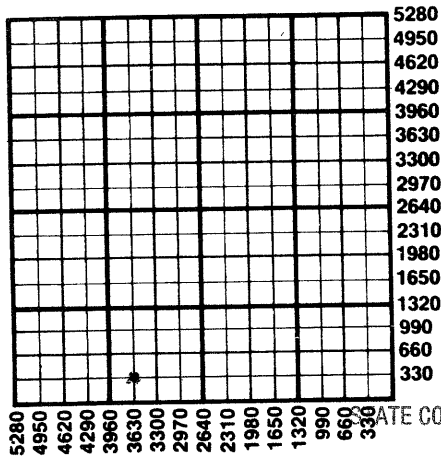

1. Notify District office before setting surface casing.
2. Set surface casing by circulating cement to the top.
3. File completion forms ACO-1 with K.C.C. within 90 days of well completion, following instructions on ACO-1, side 1, and including copies of wireline logs.
4. Notify District office 48 hours prior to old well workover or re-entry.
5. Prior to plugging, prepare a plugging plan, then obtain agreement from the appropriate district office for an approved plugging plan.
6. Submit plugging report (CP-4) to K.C.C. after plugging is completed.
7. Obtain an approved injection docket number before disposing of salt water.
8. Notify K.C.C. within 10 days when injection commences or terminates.
9. If an alternate 2 completion, cement in the production pipe from below any usable water to surface within 120 days of spud date.

RECEIVED
STATE CORPORATION COMMISSION

**State Corporation Commission of Kansas
Conservation Division
200 Colorado Derby Building
Wichita, Kansas 67202
(316) 263-3238**

MAR 06 1985
MAR 06, 1985
CONSERVATION DIVISION
Wichita, Kansas