

CARD MUST BE TYPED

State of Kansas

CARD MUST BE SIGNED

NOTICE OF INTENTION TO DRILL

Correction

(see rules on reverse side)

Expected Spud Date. APRIL 10, 1987
month day year

API Number 15— 12-26,797-00-00 4-17-87

OPERATOR: License # #5115
Name REESE EXPLORATION, INC.
Address 5540 RAYTOWN ROAD
City/State/Zip RAYTOWN, MO 64133
Contact Person PATTIE
Phone 816-356-1970

CONTRACTOR: License # 9545
Name K-O DRILLING
City/State ROUTE 1, LEROY, KS 66857

Well Drilled For: Well Class: Type Equipment:
Oil Storage Infield Mud Rotary
Gas Inj Pool Ext Air Rotary
OWWO Expl Wildcat Cable

If OWWO: old well info as follows:

Operator
Well Name
Comp Date Old Total Depth

I certify that well will comply with K.S.A. 55-101, et seq., plus eventually plugging hole to KCC specifications.

Date 4/17/87 Signature of Operator or Agent [Signature] Title AS AGENT

For KCC Use:

Conductor Pipe Required _____ feet; Minimum Surface Pipe Required _____ feet per Alt. 20

This Authorization Expires 12-10-87 Approved By 4-10-87

KWAS 3140 FEL

APPROX SE SE NW 24 Twp 16 S, Rg 21
2815 Ft. from South Line of Section
2840 Ft. from East Line of Section

(Note: Locate well on Section Plat on reverse side)


Nearest lease or unit boundary line 500 feet
County MIAMI
Lease Name SCHENDEL Well # 1-87
Ground surface elevation _____ feet MSL
Domestic well within 330 feet: yes X no
Municipal well within one mile: yes X no
Depth to bottom of fresh water _____
Depth to bottom of usable water 200
Surface pipe by Alternate: 1 2 X
Surface pipe planned to be set 40
Conductor pipe required _____
Projected Total Depth 750 feet
Formation SQUIRREL

Must be filed with the K.C.C. five (5) days prior to commencing well
 This card void if drilling not started within six (6) months of date received by K.C.C.

Important procedures to follow:

1. Notify District office before setting surface casing.
2. Set surface casing by circulating cement to the top.
3. File completion forms ACO-1 with K.C.C. within 120 days of well spud date, following instructions on ACO-1, side 1, and including copies of wireline logs.
4. Notify District office 48 hours prior to old well workover or re-entry.
5. Prior to filing Intent, prepare a proposed plugging plan in case well is D & A, then obtain approval of plan when calling district office prior to setting surface pipe.
6. Submit plugging report (CP-4) to K. C. C. after plugging is completed.
7. Obtain an approved injection docket number before disposing of salt water.
8. Notify K.C.C. within 10 days when injection commences or terminates.

A Regular Section of Land
1 Mile = 5,280 Ft.

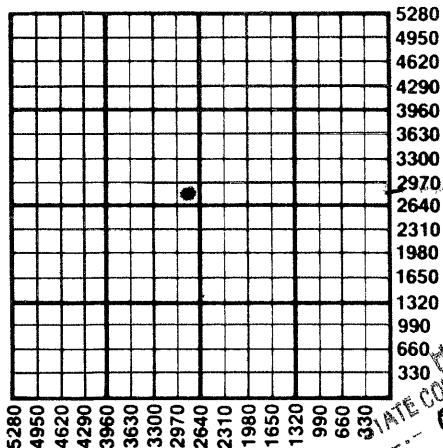

RECEIVED
 STATE CORPORATION COMMISSION
 04-17-87
 APR 17 1987
 CONSERVATION DIVISION
 WICHITA, KANSAS

9. Obtain an alternate 2 completion, cement in the production pipe from below any usable water to surface within 120 days of spud date.

State Corporation Commission of Kansas
 Conservation Division
 200 Colorado Derby Building
 Wichita, Kansas 67202-1212
 (316) 263-3238