

CARD MUST BE TYPED

State of Kansas

CARD MUST BE SIGNED

NOTICE OF INTENTION TO DRILL

(see rules on reverse side)

CORRECTION / ~~WSW~~ *
-00-11-24-87

Expected Spud Date..... 07/08/87
 month day year
 OPERATOR: License #..... 5115
 Name..... REESE EXPLORATION
 Address..... 5540 RAYTOWN RD
 City/State/Zip..... RAYTOWN 64133
 Contact Person..... L. J. REESE
 Phone..... (816) 356-1970

CONTRACTOR: License # 5661
 Name... KELLY DOWN DRILLING CO., INC.
 City/State... ROUTE 1, NEOSHO, KS 66758

Well Drilled For: Well Class: Type Equipment:
 ___ Oil ___ Storage Infield Mud Rotary
 ___ Gas ___ Inj ___ Pool Ext. ___ Air Rotary
 ___ OWWO ___ Expl ___ Wildcat ___ Cable

If OWWO: old well info as follows: WATER SUPPLY WELL
 Operator.....
 Well Name.....
 Comp Date..... Old Total Depth.....

I certify that well will comply with K.S.A. 55-101, et seq., plus eventually plugging hole to KCC specifications.
 Date ..1.1./24./87... Signature of Operator or Agent .. *Greg Engle* .. Title.. AS AGENT

For KCC Use:
 Conductor Pipe Required feet: Minimum Surface Pipe Required feet per Alt. **X2**
 This Authorization Expires 12-19-87 Approved By Perd. 11-24-87

*WAS: C S/2 1320' FSL
 2640 FEL

121-26,826-00-11-24-87
 API Number 15-
~~0-32~~ **SW-NW-NE-SE**
 Sec. 24 Twp. 16 S, Rg. 21
 2000 Ft. from South Line of Section
 1070 Ft. from East Line of Section

(Note: Locate well on Section Plat on reverse side)
 Nearest lease or unit boundary line..... 1320 feet
 County..... MTAMI
 Lease Name..... CAYOT Well #..... WSW 1
 Ground surface elevation feet MSL
 Domestic well within 330 feet: ___yes no
 Municipal well within one mile: ___yes no
 Depth to bottom of fresh water..... 100
 Depth to bottom of usable water..... 200
 Surface pipe by Alternate: 1 ___ 2 ___ X
 Surface pipe planned to be set..... 20
 Conductor pipe required
 Projected Total Depth 1000 feet
 Formation..... MISSISSIPPIAN


Approved By Perd. 11-24-87
 ORIB. RCV'D 6-19-87

Must be filed with the K.C.C. five (5) days prior to commencing well
 This card void if drilling not started within six (6) months of date received by K.C.C.

Important procedures to follow:

1. Notify District office before setting surface casing.
2. Set surface casing by circulating cement to the top.
3. File completion forms ACO-1 with K.C.C. within 120 days of well spud date, following instructions on ACO-1, side 1, and including copies of wireline logs.
4. Notify District office 48 hours prior to old well workover or re-entry.
5. Prior to filing Intent, prepare a proposed plugging plan in case well is D & A, then obtain approval of plan when calling district office prior to setting surface pipe.
6. Submit plugging report (CP-4) to K.C.C. after plugging is completed.
7. Obtain an approved injection docket number before disposing of salt water.
8. Notify K.C.C. within 10 days when injection commences or terminates.
9. If an alternate 2 completion, cement in the production pipe from below any usable water to surface within 120 days of spud date.

A Regular Section of Land
1 Mile = 5,280 Ft.

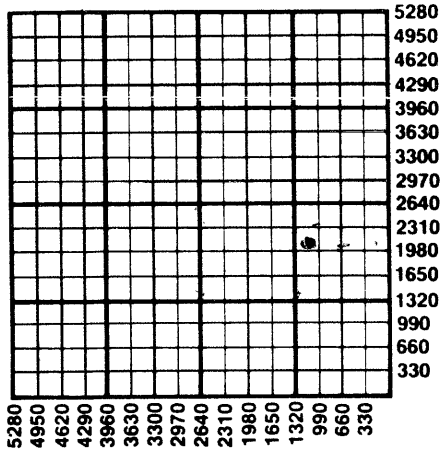

State Corporation Commission of Kansas
 Conservation Division
 200 Colorado Derby Building
 Wichita, Kansas 67202-1212
 (316) 263-3238

RECEIVED
 NOV 24 1987
 STATE CORPORATION COMMISSION
 WICHITA, KANSAS

11-24-87