

CARD MUST BE TYPED

State of Kansas

NOTICE OF INTENTION TO DRILL

CARD MUST BE SIGNED

\* CORRECTION \*

(see rules on reverse side)

Expected Spud Date... SEPTEMBER 8, 1987  
month day year

API Number 15-121-26,827-00-00

OPERATOR: License # 5115

\* NE NE X East  
S 1/2 NW Sec. 24 Twp. 16 S, Rg. 21 West

Name REESE EXPLORATION, INC.

\* 5200 Ft. from South Line of Section

Address 5540 RAYTOWN RD.

\* 2740 Ft. from East Line of Section

City/State/Zip RAYTOWN, MO. 64133

(Note: Locate well on Section Plat on reverse side)

Contact Person PATTIE

\* Nearest lease or unit boundary line 1980 feet

Phone (816) 356-1970

County MIAMI

CONTRACTOR: License # 5661

Lease Name SCHENDEL Well # WSW 1

Name KELLY DOWN DRILLING CO., INC.

Ground surface elevation feet MSL

City/State ROUTE 1, NEOSHO, KS. 66758

Domestic well within 330 feet: yes X no

Well Drilled For: Well Class: Type Equipment:

Municipal well within one mile: yes X no

Oil Storage X Infield X Mud Rotary

Depth to bottom of fresh water

Gas Inj Pool Ext Air Rotary

Depth to bottom of usable water 200

OWWO Expl Wildcat Cable

Surface pipe by Alternate: 1 2 X

If OWWO: old well info as follows: X WATER SUPPLY WELL

Surface pipe planned to be set 20

Operator

Conductor pipe required

Well Name

Projected Total Depth 1000 feet

Comp Date Old Total Depth

Formation MISSISSIPPIAN

I certify that well will comply with K.S.A. 55-101, et seq., plus eventually plugging hole to KCC specifications.

Date 9/2/87 Signature of Operator or Agent G. Deg Engleman Title AS AGENT

For KCC Use:

Conductor Pipe Required feet; Minimum Surface Pipe Required 20 feet per Alt. X (2)

This Authorization Expires 12-19-87 Approved By G.H. 6-19-87-0216 RCV'D


\* WAS: C E/2 NW 3960 FSL Nearest Lease Line 9-2-87  
3800 FEL 1980

Must be filed with the K.C.C. five (5) days prior to commencing well  
 This card void if drilling not started within six (6) months of date received by K.C.C.

**Important procedures to follow:**

1. Notify District office before setting surface casing.
2. Set surface casing by circulating cement to the top.
3. File completion forms ACO-1 with K.C.C. within 120 days of well spud date, following instructions on ACO-1, side 1, and including copies of wireline logs.
4. Notify District office 48 hours prior to old well workover or re-entry.
5. Prior to filing Intent, prepare a proposed plugging plan in case well is D & A, then obtain approval of plan when calling district office prior to setting surface pipe.
6. Submit plugging report (CP-4) to K.C.C. after plugging is completed.
7. Obtain an approved injection docket number before disposing of salt water.
8. Notify K.C.C. within 10 days when injection commences or terminates.
9. If an alternate 2 completion, cement in the production pipe from below any usable water to surface within 120 days of spud date.

**A Regular Section of Land**  
**1 Mile = 5,280 Ft.**

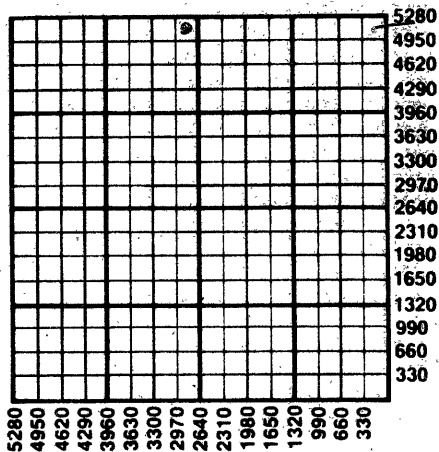

RECEIVED  
 STATE CORPORATION COMMISSION  
 SEP 2 1987  
 WICHITA, KANSAS

State Corporation Commission of Kansas  
 Conservation Division  
 200 Colorado Derby Building  
 Wichita, Kansas 67202-1212  
 (316) 263-3238

09-02-87