

CARD MUST BE TYPED

State of Kansas  
**NOTICE OF INTENTION TO DRILL**  
(see rules on reverse side)

CARD MUST BE SIGNED

Starting Date: 11 19 84  
month day year

API Number 15- 163-22,547-00-00

OPERATOR: License # 6033  
Name Murfin Drilling Company  
Address 250 N. Water, Suite 300  
City/State/Zip Wichita, KS 67202  
Contact Person David L. Murfin  
Phone 316-267-3234

SW SE SE Sec 1 Twp 7 S, Rge 20  
(location)  
330 Ft North from Southeast Corner of Section  
990 Ft West from Southeast Corner of Section  
(Note: Locate well on Section Plat on reverse side)

CONTRACTOR: License # 6033  
Name Murfin Drilling Company  
City/State Wichita, KS

Nearest lease or unit boundary line 330 feet.  
County Rooks  
Lease Name Timmons Well# 16-1

Well Drilled For: Well Class: Type Equipment:  
 Oil  Swd  Infield  Mud Rotary  
 Gas  Inj  Pool Ext.  Air Rotary  
 OWWO  Expl  Wildcat  Cable

Domestic well within 330 feet:  yes  no  
Municipal well within one mile:  yes  no

If OWWO: old well info as follows:  
Operator  
Well Name  
Comp Date Old Total Depth  
Projected Total Depth 3600 feet  
Projected Formation at TD Arbuckle  
Expected Producing Formations Arbuckle

Depth to Bottom of fresh water 100 feet  
Lowest usable water formation Dakota  
Depth to Bottom of usable water 900 feet  
Surface pipe by Alternate: 1  2x   
Surface pipe to be set 250 feet  
Conductor pipe if any required N/A feet  
Ground surface elevation Est. 2115 feet MSL  
This Authorization Expires 5-3-85  
Approved By 11-2-84

I certify that we will comply with K.S.A. 55-101, et seq., plus eventually plugging hole to K.C.C. specifications.

Date 11-2-84 Signature of Operator or Agent

James R. Daniels  
James R. Daniels, Agent for Operator


MHC/KOHE 11/2/84  
Title General Manager

**Must be filed with the K.C.C. five (5) days prior to commencing well  
This card void if drilling not started within six (6) months of date received by K.C.C.**

RECEIVED  
 STATE CORPORATION COMMISSION  
 NOV 02, 1984  
 NOV 02 1984  
 WICHITA, KANSAS

**Important procedures to follow:**

**A Regular Section of Land  
1 Mile = 5,280 Ft.**

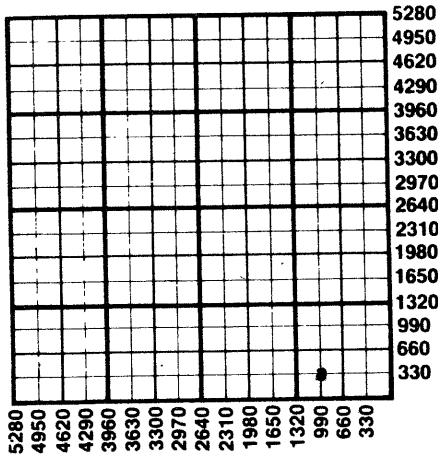

1. Notify District office before setting surface casing
2. Set surface casing by circulating cement to the top.
3. File completion forms ACO-1 with K.C.C. within 90 days of well completion, following instructions on ACO-1, side 1, and including copies of wireline logs.
4. Notify District office 48 hours prior to old well workover or re-entry.
5. Prior to plugging, prepare a plugging plan, then obtain agreement from the appropriate district office for an approved plugging plan.
6. Submit plugging report (CP-4) to K.C.C. after plugging is completed.
7. Obtain an approved injection docket number before disposing of salt water.
8. Notify K.C.C. within 10 days when injection commences or terminates.
9. If an alternate 2 completion, cement in the production pipe from below any usable water to surface within 120 days of spud date.

**State Corporation Commission of Kansas  
 Conservation Division  
 200 Colorado Derby Building  
 Wichita, Kansas 67202  
 (316) 263-3238**