

CARD MUST BE TYPED

State of Kansas

CARD MUST BE SIGNED

NOTICE OF INTENTION TO DRILL

(see rules on reverse side)

Expected Spud Date... 12/9/87 month day year

API Number 15- 163-22,914-0000

OPERATOR: License # 8061
Name Oil Producers, Inc. of Kansas
Address P.O. Box 8647
City/State/Zip Wichita, Ks. 67208
Contact Person John S. Weir
Phone 316 681-0231

NE SW NE Sec... 2 Twp... 7 S, Rg... 20 West
3630 Ft. from South Line of Section
1650 Ft. from East Line of Section

CONTRACTOR: License # 4083
Name Western Kansas Drilling
City/State Hays, Ks. 67601

(Note: Locate well on Section Plat on reverse side)
Nearest lease or unit boundary line 330 feet
County Rooks
Lease Name Ross Well # 3

Well Drilled For: Well Class: Type Equipment:
X Oil Storage X Infield X Mud Rotary
Gas Inj Pool Ext Air Rotary
OWWO Expl Wildcat Cable

Ground surface elevation feet MSL
Domestic well within 330 feet: yes no
Municipal well within one mile: yes no

If OWWO: old well info as follows:
Operator
Well Name
Comp Date Old Total Depth

Depth to bottom of fresh water
Depth to bottom of usable water 1000
Surface pipe by Alternate: 1 2 X
Surface pipe planned to be set 200
Conductor pipe required
Projected Total Depth 3700 feet
Formation Lansing, Arbuckle

I certify that well will comply with K.S.A. 55-101, et seq., plus eventually plugging hole to KCC specifications.
Date 12/4/87 Signature of Operator or Agent John S. Weir Title President

For KCC Use:
Conductor Pipe Required feet; Minimum Surface Pipe Required 200 feet per Alt. X(2)
This Authorization Expires 6-7-88 Approved By JWB 12-7-87


EFFECTIVE DATE: 12-12-87

Must be filed with the K.C.C. five (5) days prior to commencing well
 This card void if drilling not started within six (6) months of date received by K.C.C.

Important procedures to follow:

1. Notify District office before setting surface casing.
2. Set surface casing by circulating cement to the top.
3. File completion forms ACO-1 with K.C.C. within 120 days of well spud date, following instructions on ACO-1, side 1, and including copies of wireline logs.
4. Notify District office 48 hours prior to old well workover or re-entry.
5. Prior to filing Intent, prepare a proposed plugging plan in case well is D & A, then obtain approval of plan when calling district office prior to setting surface pipe.
6. Submit plugging report (CP-4) to K.C.C. after plugging is completed.
7. Obtain an approved injection docket number before disposing of salt water.
8. Notify K.C.C. within 10 days when injection commences or terminates.

A Regular Section of Land
 1 Mile = 5,280 Ft.

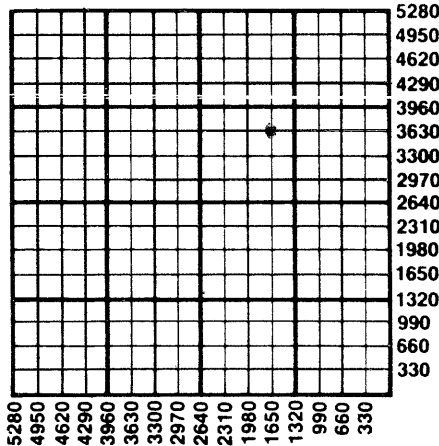

RECEIVED
 STATE CORPORATION COMMISSION

DEC 7 1987
 DEC 7, 1987
 CONSERVATION DIVISION
 Wichita, Kansas

State Corporation Commission of Kansas
 Conservation Division
 200 Colorado Derby Building
 Wichita, Kansas 67202-1212
 (316) 263-3238

Alternate 2 completion, cement in the production pipe from any usable water to surface within 120 days of spud date.