

15-179-05516-00-00

STATE OF KANSAS
STATE CORPORATION COMMISSION


Form CP-4

Give All Information Completely
Make Required Affidavit
Mail or Deliver Report to:
Conservation Division
State Corporation Commission
212 No. Market
Wichita, Kansas 67202

WELL PLUGGING RECORD

Sheridan County, Sec. 12 Twp. 6 Rge. (E) 27 (W)

Location as "NE/CNWxSWx" or footage from lines SW SE NW
Lease Owner Continental Oil Company
Lease Name Adell Well No. 209
Office Address Box 267, Great Bend, Kansas 67530
Character of Well (completed as Oil, Gas or Dry Hole) oil EOR
Date well completed 19__
Application for plugging filed 19__
Application for plugging approved 19__
Plugging commenced December 22 1971
Plugging completed December 23 1971
Reason for abandonment of well or producing formation depleted

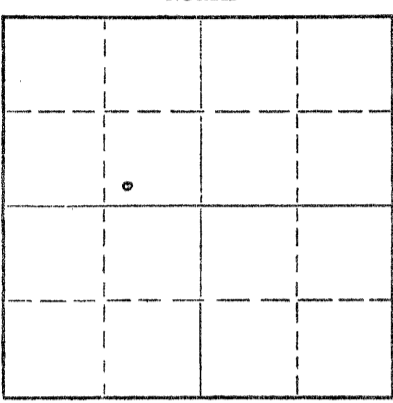

Locate well correctly on above Section Plat

If a producing well is abandoned, date of last production 19__
Was permission obtained from the Conservation Division or its agents before plugging was commenced? yes

Name of Conservation Agent who supervised plugging of this well W. L. Nichols
Producing formation _____ Depth to top _____ Bottom _____ Total Depth of Well 3930 Feet
Show depth and thickness of all water, oil and gas formations.

OIL, GAS OR WATER RECORDS

CASING RECORD

FORMATION	CONTENT	FROM	TO	SIZE	PUT IN	PULLED OUT
		0	203'	8 5/8"	203'	none
		0	3950'	5 1/2"	3950'	913.92

Describe in detail the manner in which the well was plugged, indicating where the mud fluid was placed and the method or methods used in introducing it into the hole. If cement or other plugs were used, state the character of same and depth placed, from _____ feet to _____ feet for each plug set.

Pumped in 50 sacks of cement for bottom plug.
Plugged well with 5 sacks of hulls, 35 sacks of gel and 150 sacks of cement.

RECEIVED
STATE CORPORATION COMMISSION
01-03-1972
JAN 3 1972
CONSERVATION DIVISION
Wichita, Kansas

(If additional description is necessary, use BACK of this sheet)
Name of Plugging Contractor PIPE PULLERS, INC.
Address Box 486, Ellinwood, Kansas

STATE OF KANSAS, COUNTY OF BARTON, ss.

Evelyn Roth (employee of owner) or (~~owner or operator~~) of the above-described well, being first duly sworn on oath, says: That I have knowledge of the facts, statements, and matters herein contained and the log of the above-described well as filed and that the same are true and correct. So help me God.

(Signature) Evelyn Roth
Ellinwood, Kansas
(Address)

SUBSCRIBED AND SWORN TO before me this 30th day of December, 1971

My commission expires Feb. 10, 1975
George A. Meyer
Notary Public.