


STATE OF KANSAS
STATE CORPORATION COMMISSION

Give All Information Completely
Make Required Affidavit
Mail or Deliver Report to:
Conservation Division
State Corporation Commission
800 Bitting Building
Wichita, Kansas

15-193-30005-00-00
WELL PLUGGING RECORD

NORTH

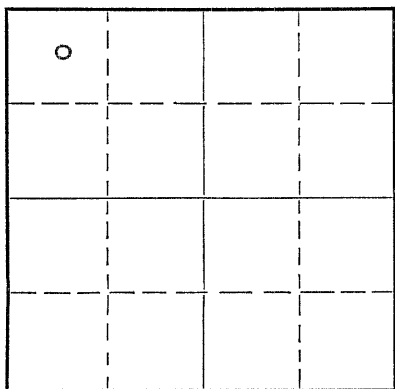

Locate well correctly on above
Section Plat

Thomas County. Sec. 4 Twp. 6 Rge. (E) 34 (W)
Location as "NE/CNW $\frac{1}{4}$ SW $\frac{1}{4}$ " or footage from lines C NW NW
Lease Owner James Oil Company
Lease Name Anna Donn Well No. 1
Office Address 12110 So. Western Ave., Los Angeles, 47, Cal.
Character of Well (completed as Oil, Gas or Dry Hole) Dry Hole
Date well completed June 6 19.60
Application for plugging filed June 7 19.60
Application for plugging approved 19
Plugging commenced June 7 19.60
Plugging completed June 8 19.60
Reason for abandonment of well or producing formation Dry Hole

If a producing well is abandoned, date of last production 19
Was permission obtained from the Conservation Division or its agents before plugging was commenced? Yes

Name of Conservation Agent who supervised plugging of this well Eldon Petty
Producing formation None Depth to top Bottom Total Depth of Well Feet
Show depth and thickness of all water, oil and gas formations.

OIL, GAS OR WATER RECORDS

CASING RECORD

Formation	Content	From	To	Size	Put In	Pulled Out

Describe in detail the manner in which the well was plugged, indicating where the mud fluid was placed and the method or methods used in introducing it into the hole. If cement or other plugs were used, state the character of same and depth placed, from feet to feet for each plug set.

Hole filled with heavy mud

Cement plugs:

460' with 20 sx
190' with 20 sx
Top of surface casing 10 sx

RECEIVED
STATE CORPORATION COMMISSION
JUN 27 1960
CONSERVATION DIVISION
Wichita, Kansas

6-27-60

(If additional description is necessary, use BACK of this sheet)

Correspondence regarding this well should be addressed to James Oil Company
Address 12110 So. Western Avenue
Los Angeles 47, California

STATE OF _____, COUNTY OF _____, ss.
_____(employee of owner) or (owner or operator) of the above-described well,
being first duly sworn on oath, says: That I have knowledge of the facts, statements, and matters herein contained and the log of the above-described well as filed and that the same are true and correct. So help me God.

(Signature) Thomas B. Melder

(Address)

SUBSCRIBED AND SWORN TO before me this 22 day of June, 1960

Karel Keenan

Notary Public.

My commission expires November 13, 1964



15-193-30005-00-00
WELL LOG BUREAU—KANSAS GEOLOGICAL SOCIETY
 508 East Murdock, Wichita, Kansas


Company. **A. K. MERY & INTER-TRANS, INC.**
 Farm. **Donn** No. **1**

SEC. **4** T. **6** R. **34W**
 C **NW NW**

Total Depth. **4782'**
 Comm. **6-1-60** Comp. **6-17-60**
 Shot or Treated.
 Contractor. **Interstate Drig.**
 Issued. **3-11-61**

County **Thomas**

KANSAS

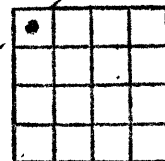

Elevation. **3136'**

8" CASING:
233'

Production. **Dry**

Figures Indicate Bottom of Formations.

COMPLETE DRILLERS LOG NOT AVAILABLE

TOPS: SCOUT	
Anhydrite	2816
Toronto	4076
Lansing	4092
Drum	4228
Base Kansas City	4348
Cherokee	4525
Mississippi	4690
Total Depth	4782