15-193-20112-00-00


FORM CP-4

STATE OF KANSAS
STATE CORPORATION COMMISSION

API 15-193-20,112

WELL PLUGGING RECORD

Give All Information Completely
Make Required Affidavit
Mail or Deliver Report to
Conservation Division
State Corporation Comm.
245 North Water
Wichita, KS 67202

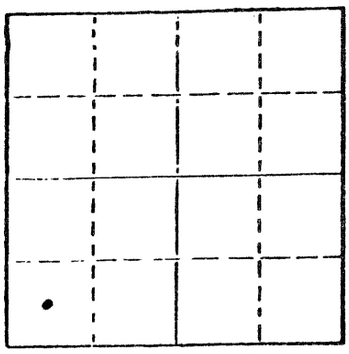

Locate well correctly on above Section Plat

THOMAS County. Sec. 11 Twp. 6S Rge. 33 E/W
Location as "NE/CNW¼SW¼" or footage from lines C SW SW
660' FSL & 668.7' FWL
Lease Owner BASS ENTERPRISES PRODUCTION CO.
Lease Name SHUGHART Well No. 1
Office Address BOX 2760, MIDLAND, TX 79702
Character of Well (Completed as Oil, Gas or Dry Hole)
DRY HOLE
Date Well completed 4-22-77 19
Application for plugging filed 4-22-77 19
Application for plugging approved 4-22-77 19
Plugging commenced 4-22-77 19
Plugging completed 4-22-77 19
Reason for abandonment of well or producing formation
DRY HOLE
If a producing well is abandoned, date of last production
— 19
Was permission obtained from the Conservation Division or its agents before plugging was commenced? YES

Name of Conservation Agent who supervised plugging of this well GILBERT BALTHAZOR
Producing formation — Depth to top — Bottom — Total Depth of Well 4200'
Show depth and thickness of all water, oil and gas formations.

OIL, GAS OR WATER RECORDS — CASING RECORD

FORMATION	CONTENT	FROM	TO	SIZE	PUT IN	PULLED OUT
				8 5/8"	334.31 GL.	NONE

Describe in detail the manner in which the well was plugged, indicating where the mud fluid was placed and the method or methods used in introducing it into the hold. If cement or other plugs were used, state the character of same and depth placed, from _____ feet to _____ feet for each plug set.

PLUG NO. 1: 70 SKS 50-50 POZ-MIX w/6% GEL AT 1650'.
PLUG NO. 2: 20 SKS 50-50 POZ-MIX w/6% GEL AT 300'.
SET 'TIGHT PLUG' @ 38' - FILLED BACK TO SURFACE WITH 10 SKS 50-50 POZ-MIX w/6% GEL

RECEIVED
STATE CORPORATION COMMISSION
MAY 02 1977
CONSERVATION DIVISION
Wichita, Kansas

(If additional description is necessary, use BACK of this sheet)
Name of Plugging Contractor RAINS & WILLIAMSON OIL CO., INC.

STATE OF TEXAS COUNTY OF MIDLAND, ss.
H.E. WURTZ, JR. (employee of owner) or ~~(owner or operator)~~ of the above-described well, being first duly sworn on oath, says: That I have knowledge of the facts, statements, and matters herein contained and the log of the above-described well as filed and that the same are true and correct. So help me God.

(Signature) H. E. Wurtz, Jr.
BOX 2760, MIDLAND, TX 79702
(Address)

SUBSCRIBED AND SWORN TO before me this 29TH day of APRIL, 1977

B. R. Brown
MIDLAND COUNTY, TEXAS, Notary Public.

My commission expires JUNE 1, 1977