

RECEIVED

OCT 26 2005

Form C-1
December 2002

For KCC Use:
Effective Date: 10-31-05
District # 3
SGA? Yes No

KANSAS CORPORATION COMMISSION
OIL & GAS CONSERVATION DIVISION

NOTICE OF INTENT TO DRILL

KCC WICHITA

Form must be Typed
Blanks must be Filled

Must be approved by KCC five (5) days prior to commencing well

Expected Spud Date 10-31-05
month day year

Spot East
NE/4 SW/4 SE/4 Sec. 32 Twp. 33 S. R. 16 West
990' feet from N / S Line of Section
1650' feet from E / W Line of Section
Is SECTION Regular Irregular?

OPERATOR: License# 32219
Name: Production Maintenance Service
Address: 3922 CR 1250
City/State/Zip: Coffeyville, KS 67337
Contact Person: Mike McClenning
Phone: 620-988-0042

(Note: Locate well on the Section Plat on reverse side)
County: Montgomery
Lease Name: Pitts Well #: 3
Field Name: Jefferson-Sycamore

CONTRACTOR: License# 5831
Name: MOKAT

Is this a Prorated / Spaced Field? Yes No
Target Formation(s): Riverton Coal
Nearest Lease or unit boundary: 330

Well Drilled For: Well Class: Type Equipment:
 Oil Enh Rec Infield Mud Rotary
 Gas Storage Pool Ext. Air Rotary
 O/WO Disposal Wildcat Cable
 Seismic; # of Holes Other
 Other

Ground Surface Elevation: 800 feet MSL
Water well within one-quarter mile: Yes No
Public water supply well within one mile: Yes No

If OWWO: old well information as follows:
Operator: _____
Well Name: _____
Original Completion Date: _____ Original Total Depth: _____

Depth to bottom of fresh water: 100'
Depth to bottom of usable water: 200'
Surface Pipe by Alternate: 1 2

Directional, Deviated or Horizontal wellbore? Yes No

Length of Surface Pipe Planned to be set: 40'
Length of Conductor Pipe required: NONE
Projected Total Depth: 1200'

If Yes, true vertical depth: _____

Formation at Total Depth: Mississippian

Bottom Hole Location: _____

Water Source for Drilling Operations:
 Well Farm Pond Other air

KCC DKT #: _____

DWR Permit #: _____

(Note: Apply for Permit with DWR)

Will Cores be taken? Yes No

If Yes, proposed zone: _____

AFFIDAVIT

The undersigned hereby affirms that the drilling, completion and eventual plugging of this well will comply with K.S.A. 55 et. seq.

It is agreed that the following minimum requirements will be met:

1. Notify the appropriate district office **prior** to spudding of well;
2. A copy of the approved notice of intent to drill **shall be** posted on each drilling rig;
3. The minimum amount of surface pipe as specified below **shall be set** by circulating cement to the top; in all cases surface pipe **shall be set** through all unconsolidated materials plus a minimum of 20 feet into the underlying formation.
4. If the well is dry hole, an agreement between the operator and the district office on plug length and placement is necessary **prior to plugging**;
5. The appropriate district office will be notified before well is either plugged or production casing is cemented in;
6. If an ALTERNATE II COMPLETION, production pipe shall be cemented from below any usable water to surface within **120 days** of spud date. Or pursuant to Appendix "B" - Eastern Kansas surface casing order #133,891-C, which applies to the KCC District 3 area, alternate II cementing must be completed within 30 days of the spud date or the well shall be plugged. **In all cases, NOTIFY district office** prior to any cementing.

I hereby certify that the statements made herein are true and to the best of my knowledge and belief.

Date: 10/24-05 Signature of Operator or Agent: [Signature] Title: Operator

For KCC Use ONLY
API # 15 - 125-30877.0000
Conductor pipe required NONE feet
Minimum surface pipe required 20 feet per Alt. (2)
Approved RJR10-2605
This authorization expires: 4-26-06
(This authorization void if drilling not started within 6 months of approval date.)
Spud date: _____ Agent: _____

Remember to:

- File Drill Pit Application (form CDP-1) with Intent to Drill;
- File Completion Form ACO-1 within 120 days of spud date;
- File acreage attribution plat according to field proration orders;
- Notify appropriate district office 48 hours prior to workover or re-entry;
- Submit plugging report (CP-4) after plugging is completed;
- Obtain written approval before disposing or injecting salt water.
- If this permit has expired (See: authorized expiration date) please check the box below and return to the address below.

Well Not Drilled - Permit Expired
Signature of Operator or Agent: _____
Date: _____

Mail to: KCC - Conservation Division, 130 S. Market - Room 2078, Wichita, Kansas 67202

32
33
16E

IN ALL CASES PLOT THE INTENDED WELL ON THE PLAT BELOW

Plat of acreage attributable to a well in a prorated or spaced field

If the intended well is in a prorated or spaced field, please fully complete this side of the form. If the intended well is in a prorated or spaced field complete the plat below showing that the well will be properly located in relationship to other wells producing from the common source of supply. Please show all the wells and within 1 mile of the boundaries of the proposed acreage attribution unit for gas wells and within 1/2 mile of the boundaries of the proposed acreage attribution unit for oil wells.

API No. 15 - _____

Operator: Production Maintenance Service _____

Lease: Pitts _____

Well Number: 3 _____

Field: Jefferson-Sycamore _____

Number of Acres attributable to well: _____

QTR / QTR / QTR of acreage: NE/4 - SW/4 - SE/4 _____

Location of Well: County: Montgomery _____

990' _____ feet from N / S Line of Section

1650' _____ feet from E / W Line of Section

Sec. 32 Twp. 33 S. R. 16 East West

Is Section: Regular or Irregular



If Section is Irregular, locate well from nearest corner boundary.

Section corner used: NE NW SE SW

PLAT

(Show location of the well and shade attributable acreage for prorated or spaced wells.)

(Show footage to the nearest lease or unit boundary line.)

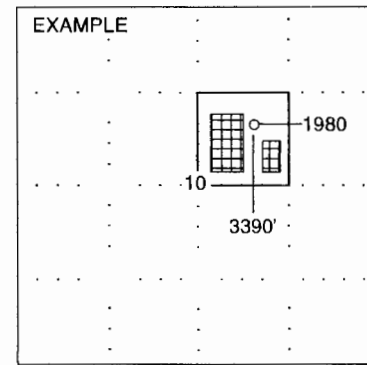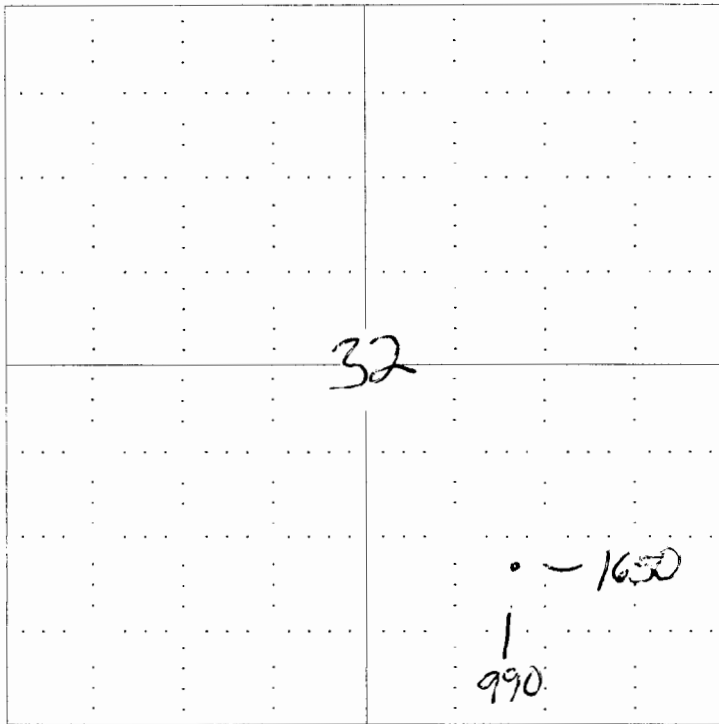

NOTE: In all cases locate the spot of the proposed drilling locaton.

In plotting the proposed location of the well, you must show:

1. The manner in which you are using the depicted plat by identifying section lines, i.e. 1 section, 1 section with 8 surrounding sections, 4 sections, etc.
2. The distance of the proposed drilling location from the section's south / north and east / west.
3. The distance to the nearest lease or unit boundary line.
4. If proposed location is located within a prorated or spaced field a certificate of acreage attribution plat must be attached: (CO-7 for oil wells; CG-8 for gas wells).