


15-193-30008-00-00

Give All Information Completely
Make Required Affidavit
Mail or Deliver Report to:
Conservation Division
State Corporation Commission
212 North Market, Insurance Bldg.
Wichita, Kansas

WELL PLUGGING RECORD

Thomas County. Sec. 16 Twp. 6S Rge. (E) 36 (W)
Location as "NE/CNW/SW" or footage from lines C NW SW
Lease Owner James Oil Company
Lease Name Hazen Well No. 1
Office Address 12110 South Western; Los Angeles 47, California
Character of Well (completed as Oil, Gas or Dry Hole) Dry Hole
Date well completed March 9th 19 60
Application for plugging filed March 9 19 60
Application for plugging approved March 9 19 60
Plugging commenced March 9 19 60
Plugging completed March 10 19 60
Reason for abandonment of well or producing formation _____

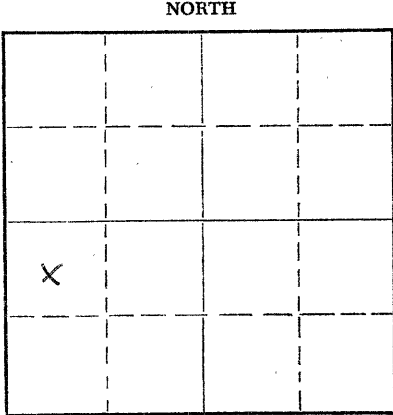

Locate well correctly on above Section Plat

If a producing well is abandoned, date of last production _____ 19 ____
Was permission obtained from the Conservation Division or its agents before plugging was commenced? Yes

Name of Conservation Agent who supervised plugging of this well Fabricus
Producing formation _____ Depth to top _____ Bottom _____ Total Depth of Well 5010 Feet
Show depth and thickness of all water, oil and gas formations.

OIL, GAS OR WATER RECORDS

CASING RECORD

FORMATION	CONTENT	FROM	TO	SIZE	PUT IN	PULLED OUT
<u>Dakota Sands</u>	<u>Saltwater</u>	<u>2400</u>	<u>2800</u>	<u>8 5/8</u>	<u>316</u>	<u>None</u>

Describe in detail the manner in which the well was plugged, indicating where the mud fluid was placed and the method or methods used in introducing it into the hole. If cement or other plugs were used, state the character of same and depth placed, from _____ feet to _____ feet for each plug set.

Hole Filled with Heavy Mud

Cement plugs:

- 500' with 20 sx
- 250' with 20 sx
- Top of surface Casing 10 sx

RECEIVED
STATE CORPORATION COMMISSION
MAR 15 1960
CONSERVATION DIVISION
Wichita, Kansas

3-15-60

(If additional description is necessary, use BACK of this sheet)

Name of Plugging Contractor James Oil Company
Address 12110 South Western; Los Angeles 47, California

STATE OF Oklahoma, COUNTY OF Tulsa, ss.
C. S. Cannan (employee of owner) or (owner or operator) of the above-described well, being first duly sworn on oath, says: That I have knowledge of the facts, statements, and matters herein contained and the log of the above-described well as filed and that the same are true and correct. So help me God.

(Signature) C. S. Cannan

307 Pan American Bldg.; Tulsa, Oklahoma
(Address)

SUBSCRIBED AND SWORN TO before me this 14 day of March, 19 60

My commission expires July 22, 1963

John W. Caldwell
Notary Public.

