


STATE OF KANSAS
STATE CORPORATION COMMISSION

15-193-00002-00-00

Give All Information Completely
Make Required Affidavit
Mail or Deliver Report to:
Conservation Division
State Corporation Commission
211 No. Broadway
Wichita, Kansas

WELL PLUGGING RECORD

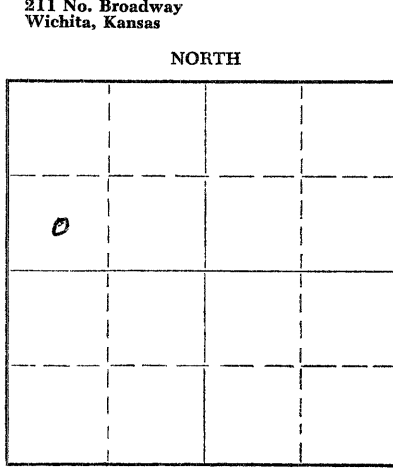

Locate well correctly on above Section Plat

Thomas County. Sec. 6 Twp. 6 Rge. (E) 36 (W)
Location as "NE/CNW/SW" or footage from lines C-SW-NW
Lease Owner Jackson, Shear & Parker
Lease Name Briney Well No. 1
Office Address Box 149, Duncan, Oklahoma
Character of Well (completed as Oil, Gas or Dry Hole) Dry Hole
Date well completed 7-2-58 19
Application for plugging filed 7-2-58 19
Application for plugging approved 7-2-58 19
Plugging commenced 7-2-58 19
Plugging completed 7-2-58 19
Reason for abandonment of well or producing formation Dry Hole

If a producing well is abandoned, date of last production 19
Was permission obtained from the Conservation Division or its agents before plugging was commenced? Yes

Name of Conservation Agent who supervised plugging of this well A. D. Fabricius
Producing formation _____ Depth to top _____ Bottom _____ Total Depth of Well 5300 Feet
Show depth and thickness of all water, oil and gas formations.

OIL, GAS OR WATER RECORDS

CASING RECORD

FORMATION	CONTENT	FROM	TO	SIZE	PUT IN	PULLED OUT
Surface soil & clay		0	45			
Clay, sand, gravel		45	320			
Red Bed		320	330	8 5/8	330	None

Describe in detail the manner in which the well was plugged, indicating where the mud fluid was placed and the method or methods used in introducing it into the hole. If cement or other plugs were used, state the character of same and depth placed, from _____ feet to _____ feet for each plug set.

Gunned pits to raise weight and viscosity of mud.
Circulated heavy mud.
Heavy mud from T.D. to 600'
1/3 sack of hulls in sack @ 600'
Halliburton plug @ 600'
25 sacks cement mixed through drill pipe placed on plug @ 600'
Heavy mud to 325' 1/3 sack hulls @ 325'
Halliburton plug @ 325'
15 sacks cement mixed through drill pipe placed on plug
Heavy mud to 40'
1/3 sack of hulls in sack @ 40'
Halliburton plug @ 40'
10 sacks cement to base of cellar
3/8" plate welded on surface pipe @ base of cellar
Top of surface pipe 3' below ground level.

(If additional description is necessary, use BACK of this sheet)

Name of Plugging Contractor Badger Drillers, Inc.
Address Box 287, Tulsa, Oklahoma

STATE OF Oklahoma, COUNTY OF Tulsa, ss.
Fred A. Veail (employee of owner) or (owner-or-operator) of the above-described well, being first duly sworn on oath, says: That I have knowledge of the facts, statements, and matters herein contained and the log of the above-described well as filed and that the same are true and correct. So help me God.

(Signature) Fred A. Veail
Box 287, Tulsa, Oklahoma (Address)

SUBSCRIBED AND SWORN TO before me this 7th day of July, 1958

My commission expires 6-26-60 10-20-61

Opal Graniel Notary Public.

PLUGGING
FILE SEC. 6 T. 6 R. 36W
BOOK PAGE 113 LINE 10

RECEIVED
STATE CORPORATION COMMISSION
7-12-58
JUL 12 1958
CONSERVATION DIVISION
Wichita, Kansas

15-193-0002-00-00

JACKSON, SHEAR AND PARKER
 Box 149, Duncan, Oklahoma
 SW $\frac{1}{4}$ of NW $\frac{1}{4}$ of Section 6, T-6S, R-36W
 Thomas County, Kansas

Briney #1

<u>From</u>	<u>To</u>	<u>Formation</u>	<u>From</u>	<u>To</u>	<u>Formation</u>
0	45	Surface Clay & Sand	4343	4390	Lime & Shale
45	320	Sand & Gravel	4390	4415	Lime
320	330	Redbed	4415	4480	Lime
330	1350	Shale & Shells	4480	4495	Lime
1350	1960	Shale & Shells	4495	4520	Broken Lime
1960	2330	Shale & Shells	4520	4567	Lime
2330	2640	Shale & Shells	4567	4625	Lime & Shale
2640	2815	Shale & Shells	4625	4637	Lime & Shale
2815	2860	Shale & Shells	4637	4674	Lime & Shale
2860	2898	Anhydrite	4674	4719	Lime
2898	2960	Shale	4719	4752	Lime
2960	3100	Shale	4752	4785	Lime with Sand & Chert
3100	3130	Shale & Lime	4785	4820	Lime
3130	3211	Shale & Lime	4820	4868	Hard Lime
3211	3274	Shale	4868	4891	Lime
3274	3282	Sand	4891	4908	Lime
3282	3385	Shale	4908	4939	Lime
3385	3465	Shale & Lime	4939	4958	Lime
3465	3550	Shale & Lime	4958	5000	Lime
3550	3640	Shale & Lime	5000	5029	Lime
3640	3696	Shale, Lime Streaks & Lime bed			
3696	3707	Sandy Lime	5029	5052	Lime
3707	3785	Sandy Lime & Shale	5052	5066	Cherty Lime
3785	3845	Sandy Lime	5066	5090	Lime & Chert
3845	3893	Sandy Lime & Redbed	5090	5102	Lime
3893	3980	Lime & Shale	5102	5122	Lime
3980	4055	Shale & Lime	5122	5142	Lime & Sandy Dolomite
4055	4130	Lime & Shale	5142	5172	Lime
4130	4190	Shale & Lime	5172	5179	Lime
4190	4270	Lime & Shale	5179	5197	Lime & Chert
4270	4304	Lime & Shale	5197	5218	Lime
4304	4343	Lime	5218	5244	Lime
			5244	5285	Arbuckle Lime
			5285	5300	T. D. - Dry Hole

I certify the above to be a true and exact copy of the Driller's Log as shown by the Daily Drilling Reports.

BADGER DRILLERS, INC.

Fred C. Neal

Subscribed and sworn to before me this 7th day of July, 1958.

Notary Public *Martha Maher*
 My Commission expires 6-26-60.

PLUGGING
 FILE SEC. 6 T. 6 R. 36W
 BOOK PAGE 113 LINE 12