

15-181-30000-00-00

STATE OF KANSAS  
STATE CORPORATION COMMISSION


Give All Information Completely  
Make Required Affidavit  
Mail or Deliver Report to:  
Conservation Division  
State Corporation Commission  
211 No. Broadway  
Wichita, Kansas

WELL PLUGGING RECORD

Sherman County, Sec. 2 Twp. 6S Rge. 37 (E) (W)

Location as "NE/CNW/SW" or footage from lines SW SW SW  
Lease Owner Min Oil Company  
Lease Name Fletcher Well No. 1  
Office Address Russell, Kansas  
Character of Well (completed as Oil, Gas or Dry Hole) Dry Hole  
Date well completed 7-28-62 19  
Application for plugging filed 7-28-62 19  
Application for plugging approved 7-28-62 19  
Plugging commenced 7-28-62 19  
Plugging completed 7-28-62 19  
Reason for abandonment of well or producing formation Dry Hole

NORTH

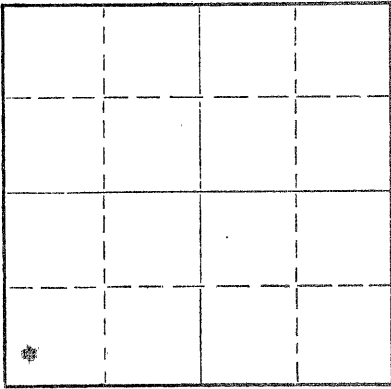

Locate well correctly on above  
Section Plat

If a producing well is abandoned, date of last production None 19  
Was permission obtained from the Conservation Division or its agents before plugging was commenced? Yes

Name of Conservation Agent who supervised plugging of this well Eldon Petty  
Producing formation None Depth to top \_\_\_\_\_ Bottom \_\_\_\_\_ Total Depth of Well \_\_\_\_\_ Feet  
Show depth and thickness of all water, oil and gas formations.

OIL, GAS OR WATER RECORDS

CASING RECORD

FORMATION	CONTENT	FROM	TO	SIZE	PUT IN	PULLED OUT
		0	368	8 5/8	368	0

Describe in detail the manner in which the well was plugged, indicating where the mud fluid was placed and the method or methods used in introducing it into the hole. If cement or other plugs were used, state the character of same and depth placed, from \_\_\_\_\_ feet to \_\_\_\_\_ feet for each plug set.

Hole filled with mud to 360', 1/2 sack hulls, plug and 25 sacks cement. Mud hole to 40', 1/2 sack hulls, plug and 10 sacks cement.

RECEIVED  
STATE CORPORATION COMMISSION  
AUG 9 1962  
CONSERVATION DIVISION  
Wichita, Kansas

8-9-62

(If additional description is necessary, use BACK of this sheet)

Name of Plugging Contractor Torrel Drilling & Producing  
Address Russell, Kansas

STATE OF KANSAS COUNTY OF RUSSELL, ss.  
Joe K. Branum, Contractor (employee of owner) or (owner or operator) of the above-described well, being first duly sworn on oath, says: That I have knowledge of the facts, statements, and matters herein contained and the log of the above-described well as filed and that the same are true and correct. So help me God.

(Signature) Joe K. Branum  
754 East Wichita, Russell, Kansas  
(Address)

SUBSCRIBED AND SWORN to before me this 2nd day of August, 1962

November 13, 1963.  
My commission expires \_\_\_\_\_  
Mary Anna Branum  
Notary Public.



13-181-30000-00-00

WELL LOG

OPERATOR: Kim Oil Company  
Russell, Kansas

CONTRACTOR: Terrel Drilling & Producing  
Russell, Kansas

LEASE: Fletcher # 1

COMMENCED: 6-24-62

LOCATION: SW-SW-SW, 2-69-E7W  
Sherman County, Kansas

COMPLETED: 7-28-62

DEPTHS & FORMATIONS

Clay & Shale	385	Line	4195
Shells & Shale	970	Line & Shale	4387
Shale	1760	Line	4774
Shale & Line	4050	Shale Streaks	4843
		Shale & Line	4967 R.T.D.

STATE OF KANSAS

COUNTY OF RUSSELL ss

Joe E. Bramum, owner of Terrel Drilling & Producing, being first duly sworn on oath says: That I have knowledge of the facts, statements, and matters herein contained and the log of the above described well as filed and that the same are true and correct.

Joe E. Bramum  
Joe E. Bramum

Subscribed and sworn before me this 2nd day of August, 1962.

Mary Anna Bramum  
Notary Public Russell County

My Commission Expires: November 13, 1963.

RECEIVED  
STATE CORPORATION COMMISSION

AUG 9 1962

CONSERVATION DIVISION  
Wichita, Kansas

8-9-62