

This form shall be filed in duplicate with the Kansas Corporation Commission, 200 Colorado Derby Building, Wichita, Kansas 67202, within ten days after the completion of the well, regardless of how the well was completed.

Attach separate letter of request if the information is to be held confidential. If confidential, only file one copy. Information on side one will be of public record and side two will then be held confidential.

Circle one: Oil Gas, Dry, SWD, OWWO, Injection. Type and complete ALL sections.

Applications must be filed for dual completion, commingling, SWD and injection, T.A.

Attach wireline logs (i.e. electrical log, sonic log, gamma ray neutron log, etc.).

KCC # (316) 263-3238. (Rules 82-2-105 & 82-2-125) NO LOGS

OPERATOR Columbia Petroleum Inc.

API NO. 15-163-21, 430 -06-00

ADDRESS Parkade Plaza, Suite 8

COUNTY Rooks

Columbia, MO, 65201

FIELD Rifles Extension RYFFE

CONTACT PERSON Robert F. Randolph

PROD. FORMATION Arbuckle

PHONE (314) 449-2224

LEASE Kriley D

PURCHASER CRA Inc.

WELL NO. 4

ADDRESS P. O. Box 7305

WELL LOCATION SE SW SW

Kansas City, MO, 64116

990 Ft. from west Line and

DRILLING Ranger Drilling Inc.

330 Ft. from south Line of

CONTRACTOR

ADDRESS P. O. Box 856

the SW/4 SEC. 20 TWP. 7S RGE. 17W


Hays, KS, 67601

PLUGGING

CONTRACTOR

ADDRESS

WELL PLAT

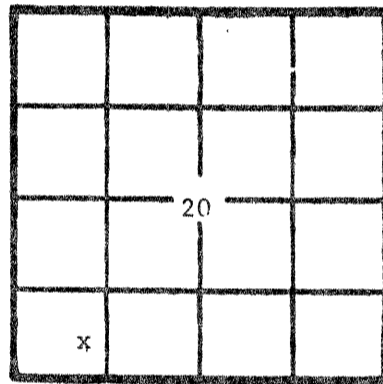

KCC [checked] KGS [checked] (Office Use)

TOTAL DEPTH 3,250 PBD

SPUD DATE 11/12/81 DATE COMPLETED 11/17/81

ELEV: GR 1,775 DF 1,778 KB 1,780

DRILLED WITH (CABLE) (ROTARY) (AIR) TOOLS

Amount of surface pipe set and cemented 1,182 DV Tool Used?

AFFIDAVIT

STATE OF MISSOURI, COUNTY OF BOONE SS, I,

Robert F. Randolph OF LAWFUL AGE, BEING FIRST DULY SWORN UPON HIS OATH,

DEPOSES THAT HE IS vice president/comptroller (FOR)(OF) Columbia Petroleum Inc.

OPERATOR OF THE Kriley D LEASE, AND IS DULY AUTHORIZED TO MAKE

THIS AFFIDAVIT FOR AND ON THE BEHALF OF SAID OPERATOR, THAT WELL NO. 4 ON

SAID LEASE HAS BEEN COMPLETED AS OF THE 25th DAY OF November, 1981, AND THAT

ALL INFORMATION ENTERED HEREIN WITH RESPECT TO SAID WELL IS TRUE AND CORRECT.

FURTHER AFFIANT SAITH NOT.

Handwritten: #487 Rec'd 2-1-82

(S) Robert F. Randolph

SUBSCRIBED AND SWORN BEFORE ME THIS 13 DAY OF July, 1982.

Blaine E. Jett

MY COMMISSION EXPIRES: January 7, 1983

NOTARY PUBLIC

The person who can be reached by phone regarding any questions concerning this information. Within 45 days of completion, a witnessed initial test by the Commission is required if the well produces more than 25 BOPD or is located in a Basic Order Pool.