

WELL PLUGGING RECORD

Give All Information Completely  
Make Required Affidavit  
Mail or Deliver Report to  
Conservation Division  
State Corporation Comm.  
200 Colorado Derby Bldg.  
202 W. 1st St.  
Wichita, KS 67202

Rooks County Sec. 35 Twp. 7s Rge. 16W  
Location as "NE/CNW/SW" or footage from lines  
NW NE SE

Lease Owner Liberty Enterprises Inc.

Lease Name Kee Well No. #1

Office Address 308 W. Mill St Plainville, Ks. 67663

Character of Well (Completed as Oil, Gas or Dry Hole)  
Dry Hole

Date Well completed September 9 1982

Application for plugging filed September 10 1982

Application for plugging approved September 10 1982

Plugging commenced 1:30 A.M. 9-10 1982

Plugging completed 3:00 A.M. 9-10 1982

Reason for abandonment of well or producing formation  
No Commercial Production


If a producing well is abandoned, date of last production  
19

Was permission obtained from the Conservation Division or  
its agents before plugging was commenced?

Name of Conservation Agent who supervised plugging of this well Marion Schmidt

Producing formation Depth to top Bottom Tl. Depth of Well

Show depth and thickness of all water, oil and gas formations.

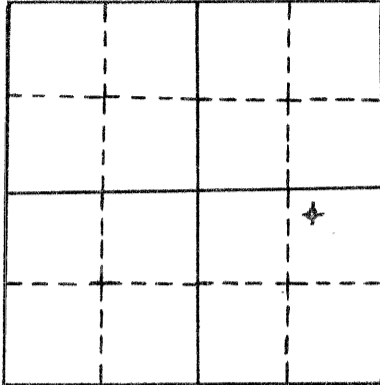

locate well correctly  
on above  
Section Plot

OIL, GAS OR WATER RECORDS

CASING RECORD

FORMATION	CONTENT	FROM	TO	SIZE	PUT IN	PULLED OUT
Surface Casing	50-50 poz	0'	265'	8 5/8"	265'	0'

Describe in detail the manner in which the well was plugged, indicating where the mud fluid was placed and the method or methods used in introducing it into the hold. If cement or other plugs were used, state the character of same and depth placed, from feet to feet for each plug set.

Plug #1 750' with 80 sxs  
 Plug #2 280' with 40 sxs  
 Plug #3 40' with 10 sxs  
 10 sxs in rathole  
 TOTAL----- 140 sxs 50-50 pos 4% gel 3%cc  
 P.D. @ 3:00 A.M. 9-10-82


STATE OF KANSAS RECEIVED  
 SEP 15 1982  
 CONSERVATION DIVISION  
 WICHITA, KANSAS

(If additional description is necessary, use BACK of this sheet)

Name of Plugging Contractor Pioneer Drilling Co.  
308 W. Mill St. Plainville, Kansas 67663

STATE OF Kansas COUNTY OF Rooks, ss.

David L. Comeau (employee of owner) or (owner or operator) of the above described well, being first duly sworn on oath, says: That I have knowledge of the facts, statements, and matters herein contained and the log of the above described well is filed and that the same are true and correct. So help me God.

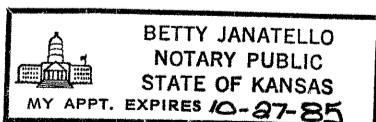

(Signature) David L. Comeau  
(Address) 308 W. Mill Plainville, Ks. 67663

SUBSCRIBED AND SWORN TO before me this 14th day of September, 1982

My commission expires 10-27-85

Betty Janatello  
Notary Public