

15-163-20470-00-00


STATE OF KANSAS  
STATE CORPORATION COMMISSION

Form CP-4

Give All Information Completely  
Make Required Affidavit  
Mail or Deliver Report to:  
Conservation Division  
State Corporation Commission  
211 No. Broadway  
Wichita, Kansas

WELL PLUGGING RECORD

NORTH

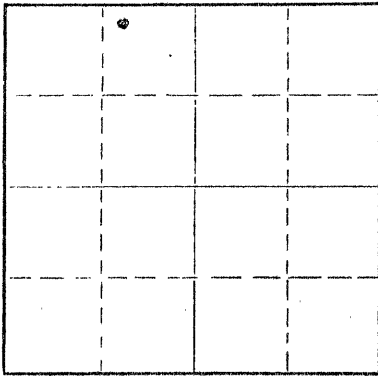

Locate well correctly on above  
Section Plat

Rooks

County. Sec. 34 Twp. 7 Rge. (E) 16(W)

Location as "NE/CNW/SW" or footage from lines: NW 1/4 NE 1/4 NW 1/4 330 N 330 W  
Lease Owner: Wilson Exploration & Development Inc.  
Lease Name: McDowell Well No. 1  
Office Address: Box 338 Wilson Kansas  
Character of Well (completed as Oil, Gas or Dry Hole): Dry  
Date well completed: Nov 6 1972 19  
Application for plugging filed: Nov 11 1972 19  
Application for plugging approved: Nov 11 1972 19  
Plugging commenced: Nov 11 1 pm 1972 19  
Plugging completed: Nov 11 3 pm 1972 19  
Reason for abandonment of well or producing formation:

If a producing well is abandoned, date of last production: 19  
Was permission obtained from the Conservation Division or its agents before plugging was commenced? Yes

Name of Conservation Agent who supervised plugging of this well: Leo Massey  
Producing formation: Depth to top: Bottom: Total Depth of Well: 3150 Feet  
Show depth and thickness of all water, oil and gas formations.

OIL, GAS OR WATER RECORDS

CASING RECORD

FORMATION	CONTENT	FROM	TO	SIZE	PUT IN	PULLED OUT
Codell Shale	8/5/8	0	220		201	None

Describe in detail the manner in which the well was plugged, indicating where the mud fluid was placed and the method or methods used in introducing it into the hole. If cement or other plugs were used, state the character of same and depth placed from feet to feet for each plug set.

Plug at 600 ft 70 sx  
Plug at 210 ft 20 sx  
Plug at 40 ft 10 sx

ALL of the above plugging was done by ALLIED CEMENTING CO INC. Russell Kansas invoice No 2904

RECEIVED  
STATE CORPORATION COMMISSION  
JAN 26 1973  
CONSERVATION DIVISION  
Wichita, Kansas

1-26-73

(If additional description is necessary, use BACK of this sheet)

Name of Plugging Contractor:  
Address:

STATE OF KANSAS, COUNTY OF ROOKS  
Julius Ehrlich, President of Wilson Exploration & Development Inc.  
well, being first duly sworn on oath, says: That I have knowledge of the facts, statements, and matters herein contained and the log of the above-described well as filed and that the same are true and correct. So help me God.

(Signature) Julius Ehrlich  
Box 338 Wilson, Kansas  
(Address)

SUBSCRIBED AND SWORN TO before me this 24 day of January, 19 73

My commission expires December 29, 1975

Stanley Kryst  
Stanley Kryst  
Notary Public.