

STATE OF KANSAS  
STATE CORPORATION COMMISSION

15-193-00025-00-00


WELL PLUGGING RECORD

Give All Information Completely  
Make Required Affidavit  
Mail or Deliver Report to:  
Conservation Division  
State Corporation Commission  
800 Bitting Building  
Wichita, Kansas

Thomas County. Sec. 16 Twp. 6 Rge. 35 (W)

Location as "NE/CNW/SW" or footage from lines SE SE SE  
Lease Owner The Derby Oil Company  
Lease Name Nickel Well No. 1  
Office Address Box 1030, Wichita, Kansas  
Character of Well (completed as Oil, Gas or Dry Hole) Dry Hole  
Date well completed October 29, 19 54  
Application for plugging filed October 29, 19 54  
Application for plugging approved October 29, 19 54  
Plugging commenced October 29, 19 54  
Plugging completed October 29, 19 54  
Reason for abandonment of well or producing formation Dry Hole

NORTH

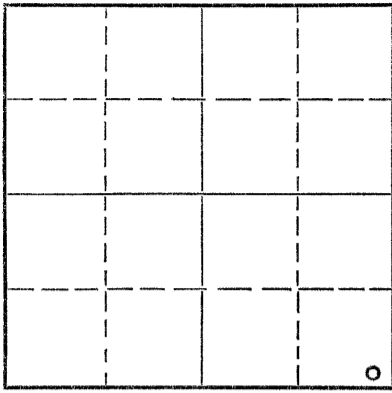

Locate well correctly on above  
Section Plat

If a producing well is abandoned, date of last production 19  
Was permission obtained from the Conservation Division or its agents before plugging was commenced? Yes

Name of Conservation Agent who supervised plugging of this well Eldon Petty  
Producing formation Depth to top Bottom Total Depth of Well Feet  
Show depth and thickness of all water, oil and gas formations.

OIL, GAS OR WATER RECORDS

CASING RECORD

FORMATION	CONTENT	FROM	TO	SIZE	PUT IN	PULLED OUT
				8 5/8	265	None

Describe in detail the manner in which the well was plugged, indicating where the mud fluid was placed and the method or methods used in introducing it into the hole. If cement or other plugs were used, state the character of same and depth placed, from feet to feet for each plug set.

Mud to 260'  
Plug @ 260' w/15 sacks cement and 1/2 sack hulls  
Mud to 40'  
Plug @ 40' w/10 sacks cement and 1/2 sack hulls to bottom of cellar.

11-12-54

(If additional description is necessary, use BACK of this sheet)  
Name of Plugging Contractor Nye & Snell  
Address Box 30, Hays, Kansas

STATE OF KANSAS, COUNTY OF SEDGWICK, ss.  
BILL K. HENRICHS (employee of owner) or (owner or operator) of the above-described well, being first duly sworn on oath, says: That I have knowledge of the facts, statements, and matters herein contained and the log of the above-described well as filed and that the same are true and correct. So help me God.

(Signature) Bill K. Henrichs  
Box 1030, Wichita, Kansas (Address)

SUBSCRIBED AND SWORN TO before me this 10th day of November, 19 54

Notary Public.

My commission expires August 24, 1957

24-7368-S 3-53-20M

