


15-193-20113-0000

STATE OF KANSAS  
STATE CORPORATION COMMISSION

WELL PLUGGING RECORD

Give All Information Completely  
Make Required Affidavit  
Mail or Deliver Report to  
Conservation Division  
State Corporation Comm.  
245 North Water  
Wichita, KS 67202

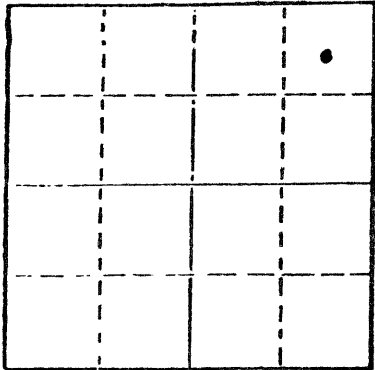

Locate well correctly on above  
Section Plat

Thomas County. Sec. 15 Twp. 6S Rge. 35 W  
Location as "NE/CNW 1/4 SW 1/4" or footage from lines  
662.1' FNL + 660' FEL - C-NE-NE  
Lease Owner BASS ENTERPRISES PRODUCTION CO.  
Lease Name TUBBS Well No. 1  
Office Address Box 2760, Midland, TX 79702  
Character of Well (Completed as Oil, Gas or Dry Hole) \_\_\_\_\_

DRY HOLE  
Date Well completed 5-2-1977  
Application for plugging filed 5-2-1977  
Application for plugging approved 5-2-1977  
Plugging commenced 5-2-1977  
Plugging completed 5-2-1977  
Reason for abandonment of well or producing formation \_\_\_\_\_

DRY HOLE  
If a producing well is abandoned, date of last production \_\_\_\_\_ 19\_\_\_\_

Was permission obtained from the Conservation Division or its agents before plugging was commenced? YES

Name of Conservation Agent who supervised plugging of this well GILBERT BANTHAZOR  
Producing formation \_\_\_\_\_ Depth to top \_\_\_\_\_ Bottom \_\_\_\_\_ Total Depth of Well 4500'  
Show depth and thickness of all water, oil and gas formations.

OIL, GAS OR WATER RECORDS

CASING RECORD

FORMATION	CONTENT	FROM	TO	SIZE	PUT IN	PULLED OUT
				<u>8 5/8"</u>	<u>355'</u>	<u>NONE</u>

Describe in detail the manner in which the well was plugged, indicating where the mud fluid was placed and the method or methods used in introducing it into the hold. If cement or other plugs were used, state the character of same and depth placed, from \_\_\_\_\_ feet to \_\_\_\_\_ feet for each plug set.

PLUG # 1: 20 SKS 50-50 POZ-MIX + 6% GEL FROM 1800' TO 1481'  
PLUG # 2: 20 SKS 50-50 POZ-MIX + 6% GEL FROM 300' TO 212'  
PLUG # 3: DROVE RUBBER PLUG TO 38' - CEMENTED WITH 10 SKS FROM 38' TO SURFACE.

RECEIVED  
STATE CORPORATION COMMISSION

MAY 12 1977

CONSERVATION DIVISION  
Wichita, Kansas

(If additional description is necessary, use BACK of this sheet) 8-12-77  
Name of Plugging Contractor RAINS & WILLIAMSON OIL CO., INC.  
720 W. DOUGLAS, WICHITA, KS 67202

STATE OF TEXAS COUNTY OF MIDLAND, ss.  
H. F. WURTY, JR. (employee of owner) or (owner or operator)  
of the above-described well, being first duly sworn on oath, says: That I have knowledge of the facts, statements, and matters herein contained and the log of the above-described well as filed and that the same are true and correct. So help me God.

(Signature) H. F. Wurtz, Jr.  
Box 2760, Midland, TX 79702  
(Address)

SUBSCRIBED AND SWORN TO before me this 10th day of MAY, 1977

My commission expires 9-10-78  
Debbie Albright  
Midland Co., Texas Notary Public.