


STATE OF KANSAS
STATE CORPORATION COMMISSION

Give All Information Completely
Make Required Affidavit
Mail or Deliver Report to:
Conservation Division
State Corporation Commission
211 No. Broadway
Wichita, Kansas

15-181-05054-0000

WELL PLUGGING RECORD

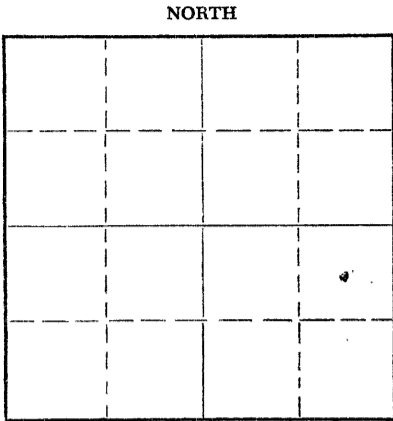

Locate well correctly on above Section Plat

Sherman County. Sec. 21 Twp. 6 Rge. 38 (E) W (W)
Location as "NE/CNW/SW" or footage from lines CNE SE
Lease Owner Phillips Petroleum Co.
Lease Name Kubert Well No. 1
Office Address Bartlesville, Okla.
Character of Well (completed as Oil, Gas or Dry Hole) DRY
Date well completed 8-7-58 19
Application for plugging filed Dec 3, 1958 19
Application for plugging approved Aug 14 19 58
Plugging commenced 8-8-58 19
Plugging completed 8-8-58 19
Reason for abandonment of well or producing formation Dry Hole

If a producing well is abandoned, date of last production _____ 19____
Was permission obtained from the Conservation Division or its agents before plugging was commenced? Yes

Name of Conservation Agent who supervised plugging of this well A.D. Fabricius Hill City, Kan
Producing formation None Depth to top _____ Bottom _____ Total Depth of Well 5477 Feet
Show depth and thickness of all water, oil and gas formations.

OIL, GAS OR WATER RECORDS

CASING RECORD

FORMATION	CONTENT	FROM	TO	SIZE	PUT IN	PULLED OUT

Describe in detail the manner in which the well was plugged, indicating where the mud fluid was placed and the method or methods used in introducing it into the hole. If cement or other plugs were used, state the character of same and depth placed, from _____ feet to _____ feet for each plug set.

Pits were banded and heavy mud pumped into hole. 35 sacks of cement were placed from 3140' to 3040'. Pits were banded and heavy mud was pumped into hole. 30 sacks of cement was placed from 317' to 217' - 10 sacks of cement at surface and pipe filled with hulls.

(If additional description is necessary, use BACK of this sheet)
Name of Plugging Contractor Halliburton
Address Hill City, Kansas

STATE OF Kansas, COUNTY OF Sherman, ss.

(employee of owner) or (owner or operator) of the above-described well, being first duly sworn on oath, says: That I have knowledge of the facts, statements, and matters herein contained and the log of the above-described well as filed and that the same are true and correct. So help me God.

(Signature) J. H. Smith
Goodland, Kan.
(Address)

SUBSCRIBED AND SWORN to before me this 4th day of December, 1958

My commission expires June 18, 1960

J. H. Smith
Notary Public.

PLUGGING
FILE SEC. 21 T. 6 R. 38 W
BOOK PAGE 122 LINE 29

DEC 5 - 1958
CONSERVATION DIVISION
Wichita, Kansas
12-5-58