


STATE OF KANSAS
STATE CORPORATION COMMISSION

15-181-30006-00-00

Give All Information Completely
Make Required Affidavit
Mail or Deliver Report to:
Conservation Division
State Corporation Commission
212 North Market, Insurance Bldg.
Wichita, Kansas

WELL PLUGGING RECORD

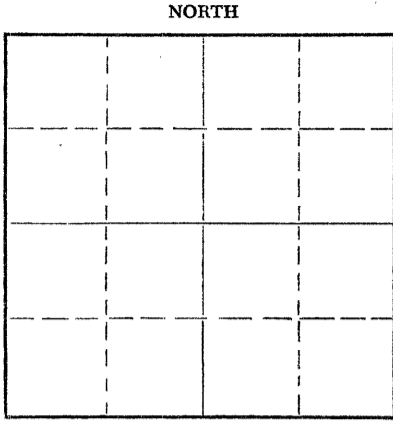

Locate well correctly on above
Section Plat

Sherman County. Sec. 9 Twp. 6S Rge. (E) 39 (W)
Location as "NE/CNW/SW" or footage from lines. SW SE
Lease Owner JOHN O. FARMER, INC.
Lease Name ZIMELMAN Well No. 1
Office Address Russell, Kansas
Character of Well (completed as Oil, Gas or Dry Hole) Dry
Date well completed 1/6 1960
Application for plugging filed 1/6 1960
Application for plugging approved 1/6 1960
Plugging commenced 1/6 1960
Plugging completed 1/6 1960
Reason for abandonment of well or producing formation Dry

If a producing well is abandoned, date of last production 19____
Was permission obtained from the Conservation Division or its agents before plugging was commenced? yes

Name of Conservation Agent who supervised plugging of this well Fabricius, Hill City, Kansas
Producing formation _____ Depth to top _____ Bottom _____ Total Depth of Well 5272 Feet
Show depth and thickness of all water, oil and gas formations.

OIL, GAS OR WATER RECORDS

CASING RECORD

FORMATION	CONTENT	FROM	TO	SIZE	PUT IN	PULLED OUT
				8-5/8"	361'	None

Describe in detail the manner in which the well was plugged, indicating where the mud fluid was placed and the method or methods used in introducing it into the hole. If cement or other plugs were used, state the character of same and depth placed, from _____ feet to _____ feet for each plug set.

First plug set at 500 feet with 20 sacks cement
Second plug set at 350 feet with 20 sacks cement
Third plug set at 40 feet with 10 sacks cement

(If additional description is necessary, use BACK of this sheet)
Name of Plugging Contractor JOHN O. FARMER, INC.
Address Russell, Kansas

STATE OF Kansas, COUNTY OF Russell, ss.
I, JOHN O. FARMER (employee of owner) (owner or operator) of the above-described well, being first duly sworn on oath, says: That I have knowledge of the facts, statements, and matters herein contained and the log of the above-described well as filed and that the same are true and correct. So help me God.
(Signature) *John O. Farmer*
Russell, Kansas (Address)

SUBSCRIBED AND SWORN TO before me this 13th day of January, 19 60

My commission expires October 11, 1962 Lucille Kennedy Notary Public.

RECEIVED
STATE CORPORATION COMMISSION

JAN 14 1960

CONSERVATION DIVISION
Wichita, Kansas