

15-181-20069-00-00

STATE OF KANSAS  
STATE CORPORATION COMMISSION


WELL PLUGGING RECORD

Give All Information Completely  
Make Required Affidavit  
Mail or Deliver Report to  
Conservation Division  
State Corporation Comm.  
245 North Water  
Wichita, KS 67202

Sherman County. Sec. 35 Twp. 6S Rge. 38 x W/W  
Location as "NE/CNW $\frac{1}{4}$ SW $\frac{1}{4}$ " or footage from lines \_\_\_\_\_

NE SW NW  
Lease Owner Abraxas Petroleum Corporation  
Lease Name Cook Well No. #1

Office Address 330 - 1100 N.E. Loop 410, San Antonio, Tex. 78217  
Character of Well (Completed as Oil, Gas or Dry Hole) \_\_\_\_\_

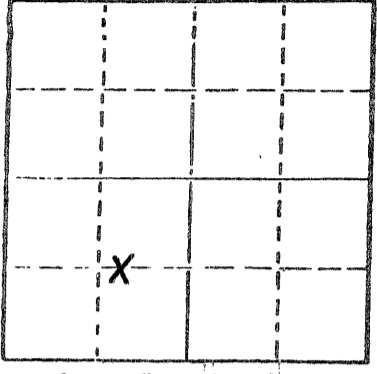

Locate well correctly on above Section Plot

Dry Hole  
Date Well completed 11-1-79 19\_\_\_\_  
Application for plugging filed 11-1-79 19\_\_\_\_  
Application for plugging approved 11-1-79 19\_\_\_\_  
Plugging commenced 11-1-79 19\_\_\_\_  
Plugging completed 11-1-79 19\_\_\_\_

Reason for abandonment of well or producing formation \_\_\_\_\_  
Commercial quantities of oil not found  
If a producing well is abandoned, date of last production \_\_\_\_\_ 19\_\_\_\_

Was permission obtained from the Conservation Division or its agents before plugging was commenced? Yes

Name of Conservation Agent who supervised plugging of this well Gilbert Balthazor, Palco, Ks.  
Producing formation \_\_\_\_\_ Depth to top \_\_\_\_\_ Bottom \_\_\_\_\_ Total Depth of Well 5130'  
Show depth and thickness of all water, oil and gas formations.

OIL, GAS OR WATER RECORDS

CASING RECORD

FORMATION	CONTENT	FROM	TO	SIZE	PUT IN	PULLED OUT
				8 5/8"	374'	None

Describe in detail the manner in which the well was plugged, indicating where the mud fluid was placed and the method or methods used in introducing it into the hold. If cement or other plugs were used, state the character of same and depth placed, from \_\_\_\_\_ feet to \_\_\_\_\_ feet for each plug set.

- Plug @ 1800' w/70 sx.
- Plug @ 340' w/20 sx.
- Plug @ 40' w/10 sx.
- Rat Hole 5 sx.

RECEIVED  
STATE CORPORATION COMMISSION  
NOV - 7 1979  
CONSERVATION DIVISION  
WICHITA, KANSAS

(If additional description is necessary, use BACK of this sheet)

Name of Plugging Contractor Rains & Williamson Oil Co., Inc.

STATE OF Kansas COUNTY OF Sedgwick  
Wilson Rains, President of Rains & Williamson Oil Co., Inc. (employee of owner) or (owner or operator)

of the above-described well, being first duly sworn on oath, says: That I have knowledge of the facts, statements, and matters herein contained and the log of the above-described well as filed and that the same are true and correct. So help me God.

(Signature) Wilson Rains  
435 Page Court, 220 W. Douglas, Wichita, Kansas 67202  
(Address)

SUBSCRIBED AND SWORN TO before me this 7 day of November, 19 79

Juanita M. Green  
Juanita M. Green Notary Public.

