


15-163-00388-00-00

STATE OF KANSAS
STATE CORPORATION COMMISSION

Give All Information Completely
Make Required Affidavit
Mail or Deliver Report to:
Conservation Division
State Corporation Commission
800 Bitting Building
Wichita, Kansas

WELL PLUGGING RECORD

Rooks County. Sec 32 Twp 7 Rge. 17 (E) W (W)
Location as "NE/CNW $\frac{1}{4}$ SW $\frac{1}{4}$ " or footage from lines Ne-NE-NW
Lease Owner Jones, Shelburne, Farmer, Inc.
Lease Name Carsten Well No. #1
Office Address Russell, Kansas.
Character of Well (~~completed as Oil, Gas or Dry Hole~~) Dry Hole
Date well completed 10-15-50 19
Application for plugging filed 10-15-50 19
Application for plugging approved 10-15-50 19
Plugging commenced 12 Noon 10-15-50 19
Plugging completed 4 P.M. 10-15-50 19
Reason for abandonment of well or producing formation

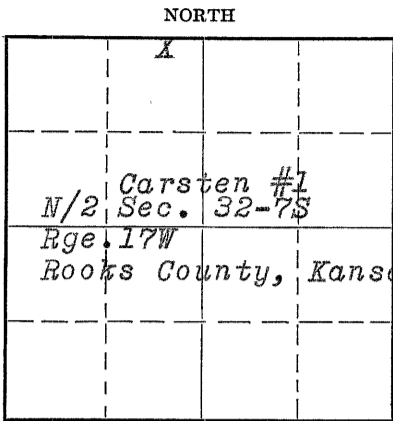

Locate well correctly on above Section Plat

If a producing well is abandoned, date of last production 19
Was permission obtained from the Conservation Division or its agents before plugging was commenced? Yes

Name of Conservation Agent who supervised plugging of this well Elden Petty
Producing formation Depth to top Bottom Total Depth of Well 3350 Feet
Show depth and thickness of all water, oil and gas formations.

OIL, GAS OR WATER RECORDS

CASING RECORD

Formation	Content	From	To	Size	Put In	Pulled Out
<u>Soil & shale</u>		<u>0</u>	<u>146'</u>	<u>10 3/4</u>	<u>146</u>	<u>0</u>
<u>Shale & red bed-shells</u>		<u>0</u>	<u>1005</u>	<u>8 5/8"</u>	<u>1005</u>	<u>0</u>

Describe in detail the manner in which the well was plugged, indicating where the mud fluid was placed and the method or methods used in introducing it into the hole. If cement or other plugs were used, state the character of same and depth placed, from feet to feet for each plug set.

Stirred pits well and filled hole with heavy mud. Placed bottom wood plug at 250', mixed and ran 20 sacks cement through drill pipe on bottom wood plug. Filled hole with heavy mud to 40'. Placed top wooden plug at 40'. Ran and mixed 10 sacks of cement and 1 sack of Hulls through drill pipe, dilling hole to bottom of cellar.

RECEIVED
STATE CORPORATION COMMISSION
OCT 20 1950
CONSERVATION DIVISION
Wichita, Kansas 10-20-50

(If additional description is necessary, use BACK of this sheet)
Correspondence regarding this well should be addressed to Strain Drilling Company.
Address Box 188 Hays, Kansas.

STATE OF Kansas, COUNTY OF Ellis, ss.
(employee of owner) or (owner or operator) of the above-described well, being first duly sworn on oath, says: That I have knowledge of the facts, statements, and matters herein contained and the log of the above-described well as filed and that the same are true and correct. So help me God.

(Signature) Florence Strain
Box 188, Hays, Kansas.
(Address)

SUBSCRIBED AND SWORN to before me this 19th day of October, 1950.
LeRoy R. Power
Notary Public.

My commission expires March 1, 1954

22-7877-s 4-49-10M

PLUGGING
FILE SEC 32 T 7 R 17
BOOK PAGE 35 LINE 33