


15-163-21070-00-00

STATE OF KANSAS
STATE CORPORATION COMMISSION

WELL PLUGGING RECORD

Give All Information Completely
Make Required Affidavit
Mail or Deliver Report to
Conservation Division
State Corporation Comm.
245 North Water
Wichita, KS 67202

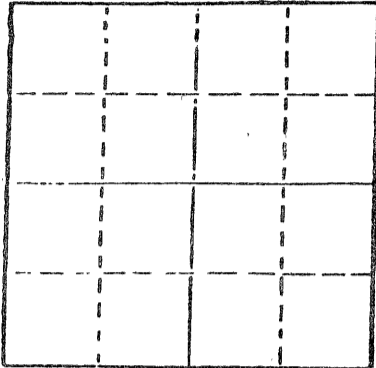

Locate well correctly on above
Section Plat

Rooks _____ County. Sec. 30 Twp. 7 Rge. 17W E/W
Location as "NE/CNW $\frac{1}{4}$ SW $\frac{1}{4}$ " or footage from lines _____
NW SE SE
Lease Owner Columbia Petroleum, Inc. % Bob Randolph
Lease Name Schruben Well No. 1
Office Address Parkaide Plaza Shopping Center
Character of Well (Completed as Oil, Gas or Dry Hole) _____
dry hole Columbia, Missouri 65201
Date Well completed May 12, 1980 19
Application for plugging filed 5/12/80 19
Application for plugging approved 5/12/80 19
Plugging commenced 6 P. M. 5/12/80 19
Plugging completed 7:30 P. M. 5/12/80 19
Reason for abandonment of well or producing formation _____
dry hole
If a producing well is abandoned, date of last production _____ 19

Was permission obtained from the Conservation Division or its agents before plugging was commenced? yes

Name of Conservation Agent who supervised plugging of this well Marion Schmidt
Producing formation _____ Depth to top _____ Bottom _____ Total Depth of Well _____
Show depth and thickness of all water, oil and gas formations.

OIL, GAS OR WATER RECORDS

CASING RECORD

FORMATION	CONTENT	FROM	TO	SIZE	PUT IN	PULLED OUT

Describe in detail the manner in which the well was plugged, indicating where the mud fluid was placed and the method or methods used in introducing it into the hold. If cement or other plugs were used, state the character of same and depth placed, from _____ feet to _____ feet for each plug set.

1st plug 780' 70 sacks
2nd plug 210' 20 sacks
solid bridge at 40' 10 sacks
Rat hole 5 sacks Total 105 Sacks 50/50-poz 6% gel

RECEIVED
STATE CORPORATION COMMISSION
MAY 14 1980
CONSTRUCTION DIVISION

(If additional description is necessary, use BACK of this sheet)

Name of Plugging Contractor Lawbanco Drilling, Inc. 5-14-80
Box 289 Natoma, Kansas 67651

STATE OF Kansas COUNTY OF Osborne, ss.
R. L. Finney (employee of owner) or (owner or operator)
of the above-described well, being first duly sworn on oath, says: That I have knowledge of the facts, statements, and matters herein contained and the log of the above-described well as filed and that the same are true and correct. So help me God.

(Signature) R. L. Finney
207 SW 8th Plainville, Kansas 67663
(Address)

SUBSCRIBED AND SWORN TO before me this 13th day of May, 19

Linda A. Zeigler
Notary Public.

My commission expires 8-29-83

