


Give All Information Completely
Make Required Affidavit
Mail or Deliver Report to:
Conservation Division
State Corporation Commission
212 No. Market
Wichita, Kansas

WELL PLUGGING RECORD

Rooks County, Sec. 5 Twp. 7S Rge. (E) 17W
Location as "NE/CNW%SW%" or footage from lines NW/4 NW/4 NW/4
Lease Owner Forrest H. Lindsay - National Associated Petroleum
Lease Name Leigh Muir Well No. 1
Office Address Fifth Floor, Ritz Building, Tulsa, Oklahoma
Character of Well (completed as Oil, Gas or Dry Hole) Dry Hole
Date well completed March 24 19 66
Application for plugging filed March 24 (verbal) 19 66
Application for plugging approved March 24 (verbal) 19 66
Plugging commenced March 24 19 66
Plugging completed March 24 19 66
Reason for abandonment of well or producing formation Dry Hole

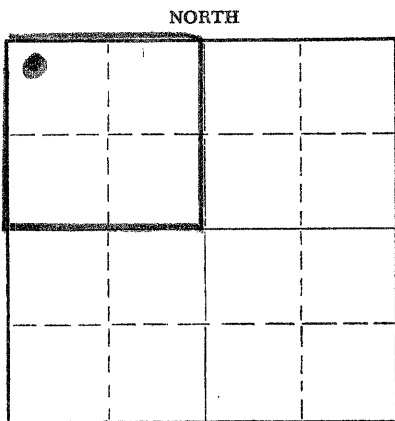

Locate well correctly on above Section Plat

If a producing well is abandoned, date of last production _____ 19____
Was permission obtained from the Conservation Division or its agents before plugging was commenced? Yes

Name of Conservation Agent who supervised plugging of this well _____
Producing formation _____ Depth to top _____ Bottom _____ Total Depth of Well 3398 Feet
Show depth and thickness of all water, oil and gas formations.

OIL, GAS OR WATER RECORDS

CASING RECORD

FORMATION	CONTENT	FROM	TO	SIZE	PUT IN	PULLED OUT

Describe in detail the manner in which the well was plugged, indicating where the mud fluid was placed and the method or methods used in introducing it into the hole. If cement or other plugs were used, state the character of same and depth placed, from _____ feet to _____ feet for each plug set.

Plug - Mud to 540'
20 sacks cement - mud to 40'
8 sacks cement - plug w/hulls
and 2 sacks cement

RECEIVED
STATE CORPORATION COMMISSION
APR 13 1966
04-13-1966
STATE CORPORATION COMMISSION
WICHITA, KANSAS

(If additional description is necessary, use BACK of this sheet)

Name of Plugging Contractor Thoroughbred Drilling Company
Address 517 Ritz Building, Tulsa, Oklahoma

STATE OF OKLAHOMA, COUNTY OF TULSA, ss.
Dan W. Brown, Thoroughbred Drilling Company (employee of owner) or (owner or operator) of the above-described well, being first duly sworn on oath, says: That I have knowledge of the facts, statements, and matters herein contained and the log of the above-described well as filed and that the same are true and correct. So help me God.

(Signature) Dan W. Brown
517 Ritz Building, Tulsa, Oklahoma
(Address)

SUBSCRIBED AND SWORN to before me this 11th day of April, 19 66

My commission expires February 21, 1969

Maxine D. Provine
Maxine D. Provine
Notary Public.