


STATE OF KANSAS  
STATE CORPORATION COMMISSION

Give All Information Completely  
Make Required Affidavit  
Mail or Deliver Report to:  
Conservation Division  
State Corporation Commission  
800 Bitting Building  
Wichita, Kansas

15-163-00461-00-00  
WELL PLUGGING RECORD

NORTH

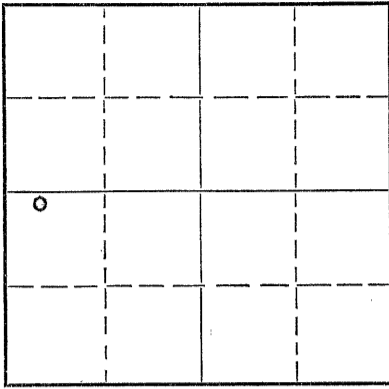

Locate well correctly on above  
Section Plat

Rocks \_\_\_\_\_ County, Sec. 5 Twp. 7 Rge. 17 (E) W (W)  
Location as "NE/CNW $\frac{1}{4}$ SW $\frac{1}{4}$ " or footage from lines 330' SNL and 330' EWL NW $\frac{1}{4}$  SW $\frac{1}{4}$   
Lease Owner T. M. Evans  
Lease Name Christine Webster Well No. 1  
Office Address Pittsburgh, Pennsylvania  
Character of Well (completed as Oil, Gas or Dry Hole) Dry hole  
Date well completed March 25 19 52  
Application for plugging filed March 24 19 52  
Application for plugging approved March 24 19 52  
Plugging commenced March 24 19 52  
Plugging completed March 24 19 52  
Reason for abandonment of well or producing formation dry

If a producing well is abandoned, date of last production \_\_\_\_\_ 19\_\_\_\_  
Was permission obtained from the Conservation Division or its agents before plugging was commenced? Yes

Name of Conservation Agent who supervised plugging of this well Eldon Petty  
Producing formation \_\_\_\_\_ Depth to top \_\_\_\_\_ Bottom \_\_\_\_\_ Total Depth of Well 3387' Feet  
Show depth and thickness of all water, oil and gas formations.

OIL, GAS OR WATER RECORDS

CASING RECORD

Formation	Content	From	To	Size	Put In	Pulled Out
		<u>0</u>	<u>165</u>	<u>8 5/8"</u>	<u>165</u>	<u>none</u>

Describe in detail the manner in which the well was plugged, indicating where the mud fluid was placed and the method or methods used in introducing it into the hole. If cement or other plugs were used, state the character of same and depth placed, from \_\_\_\_\_ feet to \_\_\_\_\_ feet for each plug set.

Filled hole with heavy mud from 3387 feet to 160 feet. Set wooden plug at 160 feet. Filled with 1/2 sack of hulls and 15 sacks of cement to 110 feet. Filled with heavy mud from 110 feet to 40 feet. Set wooden plug at 40 feet. Dumped 1/2 sack hulls on plug and filled to bottom of cellar with 10 sacks of cement.

(If additional description is necessary, use BACK of this sheet)

Name of Plugging Contractor Barnett Drilling, Inc.  
Address 623 First National Bank Bldg., Wichita 2, Kansas

03-28-1952

STATE OF Kansas, COUNTY OF Sedgwick, ss.  
F. R. Stubblefield (employee of owner) or (owner or operator) of the above-described well, being first duly sworn on oath, says: That I have knowledge of the facts, statements, and matters herein contained and the log of the above-described well as filed and that the same are true and correct. So help me God.

(Signature) [Signature]  
623 First National Bank Bldg., Wichita, Kansas  
(Address)

SUBSCRIBED AND SWORN TO before me this 27th day of March, 19 52

[Signature]  
Notary Public.

My commission expires February 27, 1956

