

WELL PLUGGING RECORD

Give All Information Completely
Make Required Affidavit
Mail or Deliver Report to
Conservation Division
State Corporation Comm.
245 North Water
Wichita, KS 67202

Rooks County Sec. 13 Twp. 7 Rge. 17 /W
Location as "NE/CNW/SW" or footage from lines
NE NE SE

Lease Owner Liberty Enterprises, Inc.

Lease Name Casad Well No. #1

Office Address 308 West Mill Plainville, KS 67663

Character of Well (Completed as Oil, Gas or Dry Hole)
Dry Hole

Date Well completed May 1, 19 81

Application for plugging filed May 1 19 81

Application for plugging approved May 1 19 81

Plugging commenced 8:20 P.M. May 1 19 81

Plugging completed 9:15 P.M. May 1 19 81

Reason for abandonment of well or producing formation
No commercial production


If a producing well is abandoned, date of last production
19

Was permission obtained from the Conservation Division or
its agents before plugging was commenced? Yes

Name of Conservation Agent who supervised plugging of this well Marion Schmidt

Producing formation Depth to top Bottom Tl. Depth of Well

Show depth and thickness of all water, oil and gas formations.

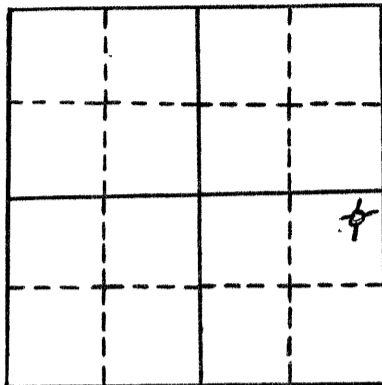

locate well correctly
on above
Section Plot

OIL, GAS OR WATER RECORDS

CASING RECORD

FORMATION	CONTENT	FROM	TO	SIZE	PUT IN	PULLED OUT
surface casing	60/40 poz common	0'	1116.'	8 5/8"	1116'	0'

Describe in detail the manner in which the well was plugged, indicating where the mud fluid was placed and the method or methods used in introducing it into the hole. If cement or other plugs were used, state the character of same and depth placed, from _____ feet to _____ feet for each plug set.

RECEIVED
MAY 26 1981
05-26-1981
CONSERVATION DIVISION
Wichita, Kansas

Plug #1 1120' with 55 sxs
Plug #2 270' with 40 sxs
Plug #3 40' with 10 sxs
1 sxs hulls with solid bridge
5 sxs in rathole
Total 105 sxs 50/50 poz 6% gel

(If additional description is necessary, use BACK of this sheet)

Name of Plugging Contractor Pioneer Drilling Company, Inc.
308 West mill Plainville, KS 67663


STATE OF Kansas COUNTY OF Rooks, ss.

David L. Comeau (employee of owner) or (owner or operator) of the above described well, being first duly sworn on oath, says: That I have knowledge of the facts, statements, and matters herein contained and the log of the above described well is filed and that the same are true and correct. So help me God.

(Signature) David Comeau
(Address) 308 West Mill Plainville, KS 67663

SUBSCRIBED AND SWORN TO before me this 22nd day of May, 19 81

My commission expires

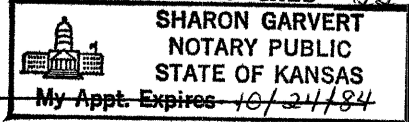

Sharon Garvert
Notary Public