

15-163-21066-00-00


STATE OF KANSAS
STATE CORPORATION COMMISSION

WELL PLUGGING RECORD

Give All Information Completely
Make Required Affidavit
Mail or Deliver Report to
Conservation Division
State Corporation Comm.
245 North Water
Wichita, KS 67202

Rooks County, Sec. 13 Twp. 7 Rge. 17 E/W
Location as "NE/CNW $\frac{1}{4}$ SW $\frac{1}{4}$ " or footage from lines
NW SE NE

Lease Owner Energy Exploration & Production, Inc.
Lease Name Cqsad Well No. 1
Office Address Suite 600 1012 Baltimore Kansas City, Mo.
Character of Well (Completed as Oil, Gas or Dry Hole)

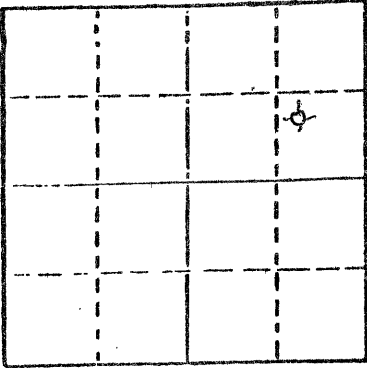

Locate well correctly on above
Section Plot

Dry hole
Date Well completed 9-19 1980
Application for plugging filed 9-19 1980
Application for plugging approved 9-19 1980
Plugging commenced 9-19 1980
Plugging completed 9-19 1980
Reason for abandonment of well or producing formation
dry hole

If a producing well is abandoned, date of last production
19

Was permission obtained from the Conservation Division or
its agents before plugging was commenced? yes

Name of Conservation Agent who supervised plugging of this well Marion Schmidt
Producing formation Depth to top Bottom Total Depth of Well 3200'
Show depth and thickness of all water, oil and gas formations.

OIL, GAS OR WATER RECORDS

CASING RECORD

FORMATION	CONTENT	FROM	TO	SIZE	PUT IN	PULLED OUT
surface		0	1178	8 5/8"	1175	0

Describe in detail the manner in which the well was plugged, indicating where the mud fluid
was placed and the method or methods used in introducing it into the hold. If cement or other
plugs were used, state the character of same and depth placed, from feet to
feet for each plug set.

1st Plug set at 1100' with 60 sacks cement 50-50 poz 6% gel

2nd Plug set at 360' with 30 sacks cement 50-50 poz 6% gel

3rd Plug set at 40' with 10 sacks cement 50-50 poz 6% gel

5 sacks in rathole

(If additional description is necessary, use BACK of this sheet)

Name of Plugging Contractor Sun Oilwell Cementing

STATE OF Kansas COUNTY OF Graham, ss.
Jerry M. Helberg (employee of owner) or (owner or operator)
of the above-described well, being first duly sworn on oath, says: That I have knowledge of
the facts, statements, and matters herein contained and the log of the above-described well
as filed and that the same are true and correct. So help me God.

(Signature)

Jerry M. Helberg
Box 32 Morland, Kansas 67850
(Address)

SUBSCRIBED AND SWORN TO before me this 2nd day of October, 1980

Janice Robinson
Notary Public.

My commission expires Dec 4, 1983

