

CARD MUST BE TYPED.

State of Kansas
NOTICE OF INTENTION TO DRILL
(see rules on reverse side)

CARD MUST BE SIGNED

Starting Date: Sept. 1, 1985
month day year

API Number 15- 163-22,736-00-00

OPERATOR: License # 7011
Name Rim Oil Co.
Address 2101 Lincoln Drive
City/State/Zip Hays, Kansas 67601
Contact Person M.D. Monroe
Phone 913-628-8694
5665

SW/NE/NE/4. Sec 20 Twp 7 S, Rge 17. East
(location) West
4290 Ft North from Southeast Corner of Section
990 Ft West from Southeast Corner of Section
(Note: Locate well on Section Plat on reverse side)

CONTRACTOR: License #
Name Pioneer Drig. Co. Inc.
City/State 308 W. Mill Plainville, Kansas

Nearest lease or unit boundary line: 330 feet.
County Rooks
Lease Name Eldon Kruley Well# 1

Well Drilled For: Well Class: Type Equipment:
 Oil Swd Infield Mud Rotary
 Gas Inj Pool Ext. Air Rotary
 OWWO Expl Wildcat Cable

Domestic well within 330 feet: yes no
Municipal well within one mile: yes no

If OWWO: old well info as follows:

Operator
Well Name
Comp Date Old Total Depth
Projected Total Depth 3600 feet
Projected Formation at TD
Expected Producing Formations

Depth to Bottom of fresh water 100 feet
Lowest usable water formation Dakota
Depth to Bottom of usable water 700 feet
Surface pipe by Alternate: 1 2
Surface pipe to be set Anhydrite (1200) feet
Conductor pipe if any required 80 feet
Ground surface elevation 1795 feet MSL
This Authorization Expires 2-7-86
Approved By 8-7-85

I certify that we will comply with K.S.A. 55-101, et seq., plus eventually plugging hole to K.C.C. specifications.

Date 8-6-85 Signature of Operator or Agent Jane M. Monroe Title Owner
RCM FORKONE


Wichita, Kansas
CONSERVATION DIVISION

Must be filed with the K.C.C. five (5) days prior to commencing well
This card void if drilling not started within six (6) months of date received by K.C.C.

1965
MAY 7
RECEIVED
STATE CORPORATION COMMISSION

S-7-85

A Regular Section of Land
1 Mile = 5,280 Ft.

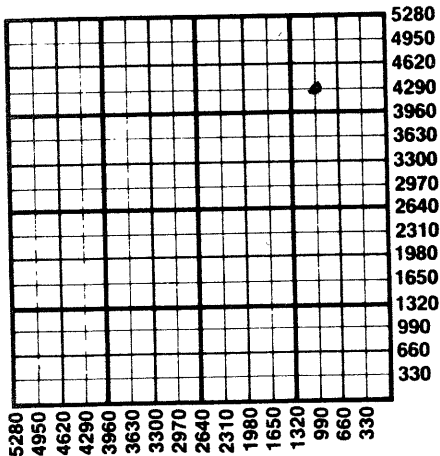

Important procedures to follow:

1. Notify District office before setting surface casing.
2. Set surface casing by circulating cement to the top.
3. File completion forms ACO-1 with K.C.C. within 90 days of well completion, following instructions on ACO-1, side 1, and including copies of wireline logs.
4. Notify District office 48 hours prior to old well workover or re-entry.
5. Prior to plugging, prepare a plugging plan, then obtain agreement from the appropriate district office for an approved plugging plan.
6. Submit plugging report (CP-4) to K.C.C. after plugging is completed.
7. Obtain an approved injection docket number before disposing of salt water.
8. Notify K.C.C. within 10 days when injection commences or terminates.
9. If an alternate 2 completion, cement in the production pipe from below any usable water to surface within 120 days of spud date.

State Corporation Commission of Kansas
Conservation Division
200 Colorado Derby Building
Wichita, Kansas 67202
(316) 263-3238