

CARD MUST BE TYPED

State of Kansas

CARD MUST BE SIGNED

### NOTICE OF INTENTION TO DRILL

(see rules on reverse side)

Starting Date ..... 1 ..... 16 ..... 1986 .....  
month day year

API Number 15- 121-26,717-00-00  
X East

OPERATOR: License # ..... 4441 .....  
Name ..... Reusch Well Service, Inc. ....  
Address ..... 401 S. Main, #11 .....  
City/State/Zip ..... Ottawa, Kansas 66067 .....  
Contact Person ..... Liz Reusch .....  
Phone ..... (913) 242-5733 .....

app. SW SW NW. Sec. 29. Twp. 16. S. Rg. 22 ..... West  
..... 3140 ..... Ft. from South Line of Section  
..... 4780 ..... Ft. from East Line of Section

(Note: Locate well on Section Plat on reverse side)

CONTRACTOR: License # ..... 4441 .....  
Name ..... Reusch Well Service, Inc. ....  
City/State ..... same as above .....

Nearest lease or unit boundary line ..... 500 ..... feet  
County ..... Miami .....  
Lease Name ..... Johnson ..... Well # .. 8 .....

Well Drilled For: Well Class: Type Equipment:  
 Oil  SWD  Infield  Mud Rotary  
 Gas  Inj  Pool Ext.  Air Rotary  
 OWWO  Expl  Wildcat  Cable

Ground surface elevation ..... feet MSL  
Domestic well within 330 feet:  yes  no  
Municipal well within one mile:  yes  no  
Surface pipe by Alternate: 1  2    
Depth to bottom of fresh water ..... 26 .....  
Depth to bottom of usable water ..... 300 200 .....  
Surface pipe planned to be set ..... 20 .....  
Projected Total Depth ..... 800 ..... feet  
Formation ..... Squirrel .....

If OWWO: old well info as follows:  
Operator .....  
Well Name .....  
Comp Date ..... Old Total Depth .....

I certify that well will comply with K.S.A. 55-101, et seq., plus eventually plugging hole to KCC specifications.

*Ret/10/86*

..... cementing will be done immediately upon setting production casing.  
Date 1/15/86 ..... Signature of Operator or Agent Mari Cholan ..... Title .. as agent .....

For KCC Use:

Conductor Pipe Required ..... feet; Minimum Surface Pipe Required ..... 20 ..... feet per Alt. X 2  
This Authorization Expires 7-15-86 ..... Approved By 1-15-86 RE .....

Must be filed with the K.C.C. five (5) days prior to commencing well  
 This card void if drilling not started within six (6) months of date received by K.C.C.


**Important procedures to follow:**

1. Notify District office before setting surface casing.
2. Set surface casing by circulating cement to the top.
3. File completion forms ACO-1 with K.C.C. within 90 days of well completion, following instructions on ACO-1, side 1, and including copies of wireline logs.
4. Notify District office 48 hours prior to old well workover or re-entry.
5. Prior to filing Intent, prepare a proposed plugging plan in case well is D & A, then obtain approval of plan when calling district office prior to setting surface pipe.
6. Submit plugging report (CP-4) to K.C.C. after plugging is completed.
7. Obtain an approved injection docket number before disposing of salt water.
8. Notify K.C.C. within 10 days when injection commences or terminates.
9. If an alternate 2 completion, cement in the production pipe from below any usable water to surface within 120 days of spud date.

**A Regular Section of Land**  
 1 Mile = 5,280 Ft.

RECEIVED  
 STATE CORPORATION COMMISSION

JAN 15 1986

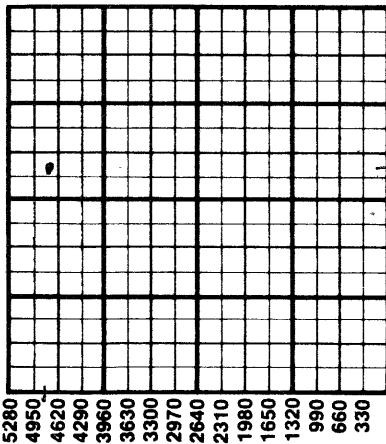

CONSERVATION DIVISION  
 WICHITA, KANSAS

State Corporation Commission of Kansas  
 Conservation Division  
 200 Colorado Derby Building  
 Wichita, Kansas 67202  
 (316) 263-3238