

CARD MUST BE TYPED

State of Kansas
NOTICE OF INTENTION TO DRILL
(see rules on reverse side)

CARD MUST BE SIGNED

Starting Date: July 9, 1984
month day year

API Number 15- 163-22, 422-00-00

OPERATOR: License # 9383
Name Black Beauty Oil
Address P.O. Box 511
City/State/Zip Hays, Kansas 67601
Contact Person Jay C. Boyer
Phone 913-625-6967

NW SE SW Sec 17 Twp 7 S, Rge 17
(location) East West

990 Ft North from Southeast Corner of Section
3360 Ft West from Southeast Corner of Section
(Note: Locate well on Section Plat on reverse side)

CONTRACTOR: License # 5665
Name Pioneer Drilling Co., Inc.
City/State Plainville, Kansas 67663

Nearest lease or unit boundary line 330 feet.
County Rooks
Lease Name Dix Well# J

Domestic well within 330 feet: yes no
Municipal well within one mile: yes no

Well Drilled For: Well Class: Type Equipment:
 Oil Swd Infield Mud Rotary
 Gas Inj Pool Ext. Air Rotary
 OWWO Expl Wildcat Cable

Depth to Bottom of fresh water 200 feet
Lowest usable water formation Dakota
Depth to Bottom of usable water 700 feet
Surface pipe by Alternate: 1 2
Surface pipe to be set 1150 feet
Conductor pipe if any required **
Ground surface elevation feet MSL
This Authorization Expires 12-20-84
Approved By 6-18-84 RC

If OWWO: old well info as follows:

Operator
Well Name
Comp Date Old Total Depth
Projected Total Depth 3300 feet
Projected Formation at TD Arbuckle
Expected Producing Formations Arbuckle

I certify that we will comply with K.S.A. 55-101, et seq., plus eventually plugging hole to K.C.C. specification ** operator, is advised to set 80' of Conductor pipe. mhc

Date 6-18-84 Signature of Operator or Agent Jay C. Boyer Title Operator

Must be filed with the K.C.C. five (5) days prior to commencing well
This card void if drilling not started within six (6) months of date received by K.C.C.

06-20-1984

Important procedures to follow:


1. Notify District office before setting surface casing.
2. Set surface casing by circulating cement to the top.
3. File completion forms ACO-1 with K.C.C. within 90 days of well completion, following instructions on ACO-1, side 1, and including copies of wireline logs.
4. Notify District office 48 hours prior to old well workover or re-entry.
5. Prior to plugging, prepare a plugging plan, then obtain agreement from the appropriate district office for an approved plugging plan.
6. Submit plugging report (CP-4) to K.C.C. after plugging is completed.
7. Obtain an approved injection docket number before disposing of salt water.
8. Notify K.C.C. within 10 days when injection commences or terminates.
9. If an alternate 2 completion, cement in the production pipe from below any usable water to surface within 120 days of spud date.

RECEIVED
STATE CORPORATION COMMISSION

JUN 20 1984

CONSERVATION DIVISION
Wichita, Kansas

A Regular Section of Land
1 Mile = 5,280 Ft.

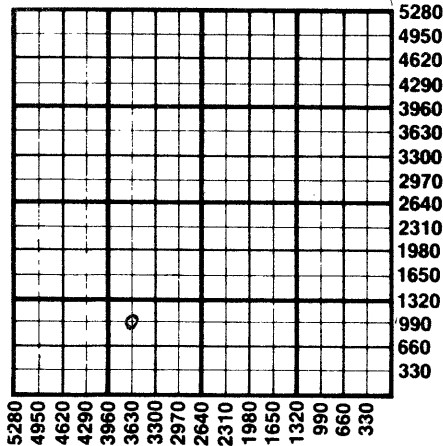

State Corporation Commission of Kansas
Conservation Division
200 Colorado Derby Building
Wichita, Kansas 67202
(316) 263-3238