

CARD MUST BE TYPED

State of Kansas

CARD MUST BE SIGNED

### NOTICE OF INTENTION TO DRILL

(see rules on reverse side)

Expected Spud Date. . . . . OCTOBER 6, 1987  
month day year

API Number 15- 121-26,868-00-00 *SC*  
NW NE SE Sec. 31 Twp. 16 S, Rg. 22 X East

OPERATOR: License # #5353

..... 2185 Ft. from South Line of Section

Name BLOOMER WELL SERVICE

..... 805 Ft. from East Line of Section

Address P. O. BOX 40

City/State/Zip RANTOUL, KANSAS 66067

Contact Person LIZ REUSCH

Phone (913) 242-5733

CONTRACTOR: License # 4441

Name REUSCH WELL SERVICE, INC.

City/State OTTAWA, KANSAS 66067

Well Drilled For: Well Class: Type Equipment:

X Oil \_\_\_\_\_ Storage X Infield X Mud Rotary

\_\_\_\_\_ Gas \_\_\_\_\_ Inj \_\_\_\_\_ Pool Ext. \_\_\_\_\_ Air Rotary

\_\_\_\_\_ OWWO \_\_\_\_\_ Expl \_\_\_\_\_ Wildcat \_\_\_\_\_ Cable

If OWWO: old well info as follows:

Operator .....

Well Name .....

Comp Date ..... Old Total Depth.....

I certify that well will comply with K.S.A. 55-101, et seq., plus eventually plugging hole to KCC specifications.

Date 10-5-87 Signature of Operator or Agent Colley Engleman Title AS. AGENT

For KCC Use:

Conductor Pipe Required ..... feet; Minimum Surface Pipe Required ..... feet per Alt. 20

This Authorization Expires 4-5-88 Effective 10-10-87 Approved By A.H. 10-5-87 X 2

(Note: Locate well on Section Plat on reverse side)

Nearest lease or unit boundary line ..... 515 feet

County MIAMI

Lease Name COOK Well # 5

Ground surface elevation ..... feet MSL

Domestic well within 330 feet: \_\_\_\_\_ yes X no

Municipal well within one mile: \_\_\_\_\_ yes X no

Depth to bottom of fresh water.....

Depth to bottom of usable water 200

Surface pipe by Alternate: 1 2 X

Surface pipe planned to be set 20

Conductor pipe required .....

Projected Total Depth ..... 650 feet


Formation SQUIRREL

Must be filed with the K.C.C. five (5) days prior to commencing well  
 This card void if drilling not started within six (6) months of date received by K.C.C.

**Important procedures to follow:**

1. Notify District office before setting surface casing.
2. Set surface casing by circulating cement to the top.
3. File completion forms ACO-1 with K.C.C. within 120 days of well spud date, following instructions on ACO-1, side 1, and including copies of wireline logs.
4. Notify District office 48 hours prior to old well workover or re-entry.
5. Prior to filing Intent, prepare a proposed plugging plan in case well is D & A, then obtain approval of plan when calling district office prior to setting surface pipe.
6. Submit plugging report (CP-4) to K.C.C. after plugging is completed.
7. Obtain an approved injection docket number before disposing of salt water.
8. Notify K.C.C. within 10 days when injection commences or terminates.
9. If an alternate completion, cement in the production pipe from below any usable water to surface within 120 days of spud date.

**A Regular Section of Land  
 1 Mile = 5,280 Ft.**

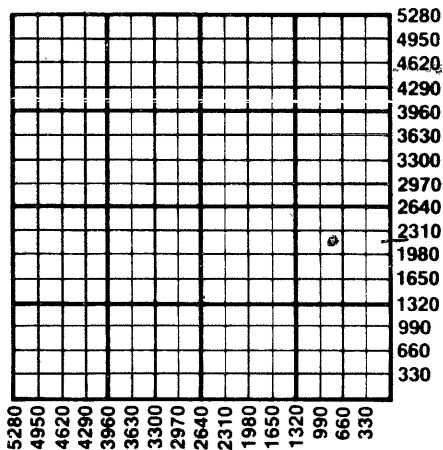

STATE COMMISSION OF KANSAS  
 CONSERVATION DIVISION  
 RECEIVED  
 OCT 13 1987

State Conservation Commission of Kansas  
 Conservation Division  
 200 Colorado Derby Building  
 Wichita, Kansas 67202-1212  
 (316) 263-3238

10-05-87