

CARD MUST BE TYPED

State of Kansas
NOTICE OF INTENTION TO DRILL

CARD MUST BE SIGNED

Starting Date: July 28, 1985
month day year

API Number 15- 121-26, 614-00-00

OPERATOR: License # 5341

App. SW SW NE Sec 31 Twp 16 S, Rge 22 East West

Name ... Glen. A. Evans

Address ... 401 South Main, Suite 11

City/State/Zip ... Ottawa, KS 66067

Contact Person Glen. Evans

Phone ... 913.242.5733

3180 Ft North from Southeast Corner of Section
2600 Ft West from Southeast Corner of Section
(Note: Locate well on Section Plat on reverse side)

CONTRACTOR: License # 8509

Name Evans Energy Development

City/State Same as above

Nearest lease or unit boundary line 520 feet

County Miami

Lease Name Bourquin Well# 15

Domestic well within 330 feet: yes no

Municipal well within one mile: yes no

Well Drilled For: Well Class: Type Equipment:

Oil Swd Infield Mud Rotary

Gas Inj Pool Ext. Air Rotary

OWWO Expl Wildcat Cable

Depth to Bottom of fresh water 26 feet

Lowest usable water formation Kansas City Group

Depth to Bottom of usable water 300-200 feet

Surface pipe by Alternate: 1 2

Surface pipe to be set 20 feet

Conductor pipe if any required feet

Ground surface elevation feet MSL

This Authorization Expires 1-26-86

Approved By RCH 7-26-85

If OWWO: old well info as follows:

Operator

Well Name

Comp Date Old Total Depth

Projected Total Depth 750 feet

Projected Formation at TD Squirrel

Expected Producing Formations

I certify that we will comply with K.S.A. 55-101, et seq., plus eventually plugging hole to K.C.C. specifications.

Date 7/26/85 Signature of Operator or Agent Elaine Barham Title as agent

Must be filed with the K.C.C. five (5) days prior to commencing well
 This card void if drilling not started within six (6) months of date received by K.C.C.


RECEIVED
 STATE CORPORATION COMMISSION
 07-26-85

A Regular Section of Land
 1 Mile = 5,280 Ft.

JUL 26 1985

Important procedures to follow:

CONSERVATION DIVISION

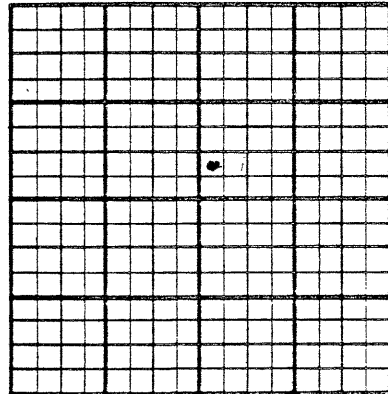

5280
 4950
 4620
 4290
 3960
 3630
 3300
 2970
 2640
 2310
 1980
 1650
 1320
 990
 660
 330

5280
 Wichita, Kansas

1. Notify District office before setting surface casing.
2. Set surface casing by circulating cement to the top.
3. File completion forms ACO-1 with K.C.C. within 90 days of well completion, following instructions on ACO-1, side 1, and including copies of wireline logs.
4. Notify District office 48 hours prior to old well workover or re-entry.
5. Prior to plugging, prepare a plugging plan, then obtain agreement from the appropriate district office for an approved plugging plan.
6. Submit plugging report (CP-4) to K.C.C. after plugging is completed.
7. Obtain an approved injection docket number before disposing of salt water.
8. Notify K.C.C. within 10 days when injection commences or terminates.
9. If an alternate 2 completion, cement in the production pipe from below any usable water to surface within 120 days of spud date.

State Corporation Commission of Kansas
 Conservation Division
 200 Colorado Derby Building
 Wichita, Kansas 67202
 (316) 263-3238