

CARD MUST BE TYPED

State of Kansas

CARD MUST BE SIGNED

NOTICE OF INTENTION TO DRILL

(see rules on reverse side)

Starting Date September 17, 1985
month day year 3-55

API Number 15- 121-26,660-00-00

OPERATOR: License # 5095
Name Gerald E. Williams
Address Box 25830
City/State/Zip Overland Park, KS 66225
Contact Person Gerald Williams
Phone 913 451 6022

App. NE SW NE Sec. 30 Twp. 16 S, Rg. 22 East
3600 West
1540 Ft. from South Line of Section
1540 Ft. from East Line of Section

(Note: Locate well on Section Plat on reverse side)

CONTRACTOR: License # 5353
Name Bloomer Well Service
City/State Box 40, Rantoul, KS 66079

Nearest lease or unit boundary line 680 feet
County Miami
Lease Name McCann Well # 33

Well Drilled For: Well Class: Type Equipment:
 Oil SWD Infield Mud Rotary
 Gas Inj Pool Ext. Air Rotary
 OWWO Expl Wildcat Cable

Ground surface elevation feet MSL
Domestic well within 330 feet: yes no
Municipal well within one mile: yes no
Surface pipe by Alternate: 1 2

If OWWO: old well info as follows:
Operator
Well Name
Comp Date Old Total Depth

Depth to bottom of fresh water 20
Depth to bottom of usable water 250 200
Surface pipe planned to be set 25
Projected Total Depth 700 feet
Formation Squirrel

I certify that well will comply with K.S.A. 55-101, et seq., plus eventually plugging hole to KCC specifications.

for S. K. O. R. E.

_____ cementing will be done immediately upon setting production casing.

Date 9/16/85 Signature of Operator or Agent *Clair G. Barham* Title as agent

For KCC Use:
Conductor Pipe Required feet; Minimum Surface Pipe Required feet per Alt 1 2
This Authorization Expires 3-15-86 Approved By 9-16-85 *RC*


Must be filed with the K.C.C. five (5) days prior to commencing well
This card void if drilling not started within six (6) months of date received by K.C.C.

Important procedures to follow:

RECEIVED
STATE CORPORATION COMMISSION
09-15-85
SEP 16 1985

A Regular Section of Land

1 Mile = 5,280 Ft.
CONSERVATION DIVISION
Wichita, Kansas

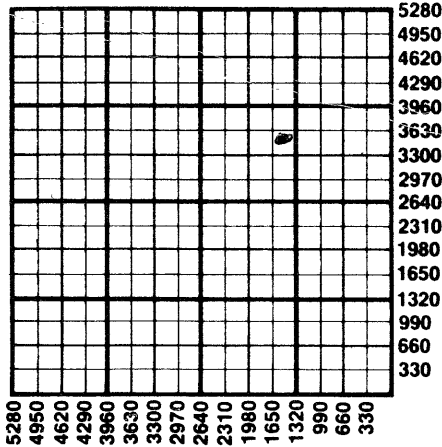

1. Notify District office before setting surface casing.
2. Set surface casing by circulating cement to the top.
3. File completion forms ACO-1 with K.C.C. within 90 days of well completion, following instructions on ACO-1, side 1, and including copies of wireline logs.
4. Notify District office 48 hours prior to old well workover or re-entry.
5. Prior to filing Intent, prepare a proposed plugging plan in case well is D & A, then obtain approval of plan when calling district office prior to setting surface pipe.
6. Submit plugging report (CP-4) to K.C.C. after plugging is completed.
7. Obtain an approved injection docket number before disposing of salt water.
8. Notify K.C.C. within 10 days when injection commences or terminates.
9. If an alternate 2 completion, cement in the production pipe from below any usable water to surface within 120 days of spud date.

State Corporation Commission of Kansas
Conservation Division
200 Colorado Derby Building
Wichita, Kansas 67202
(316) 263-3238