

CARD MUST BE TYPED

State of Kansas

CARD MUST BE SIGNED

NOTICE OF INTENTION TO DRILL

VINJ

(see rules on reverse side)

Expected Spud Date. MAY 27, 1987
month day year

234

API Number 15— 121-26809-00-00

OPERATOR: License # #5341
Name GLENN A. EVANS
Address 401 SO. MAIN #11
City/State/Zip OTTAWA, KS 66607
Contact Person GLENN EVANS
Phone 913-242-5733

NE SW NW Sec. 31 Twp. 16 S, Rg. 22
3550 Ft. from South Line of Section
4090 Ft. from East Line of Section

(Note: Locate well on Section Plat on reverse side)

CONTRACTOR: License # #8509
Name EVANS ENERGY DEVELOPMENT, Inc.
City/State OTTAWA, KANSAS 66607

Nearest lease or unit boundary line 635 feet
County MIAMI
Lease Name BEETS Well # WW2

Well Drilled For: Well Class: Type Equipment:
 Oil Storage Infill Mud Rotary
 Gas Inj Pool Ext. Air Rotary
 OWWO Expl Wildcat Cable

Ground surface elevation feet MSL
Domestic well within 330 feet: yes no
Municipal well within one mile: yes no

If OWWO: old well info as follows:
Operator
Well Name
Comp Date Old Total Depth

Depth to bottom of fresh water 26
Depth to bottom of usable water 100
Surface pipe by Alternate: 1 2
Surface pipe planned to be set 20
Conductor pipe required
Projected Total Depth 750 feet
Formation SQUIRREL

I certify that well will comply with K.S.A. 55-101, et seq., plus eventually plugging hole to KCC specifications.
Date 4/6/87 Signature of Operator or Agent Greg Cushman Title AS AGENT

For KCC Use:
Conductor Pipe Required feet; Minimum Surface Pipe Required 20 feet per Alt. 3
This Authorization Expires 11-12-87 Approved By 5-12-87


Handwritten signatures and initials:

Must be filed with the K.C.C. five (5) days prior to commencing well
 This card void if drilling not started within six (6) months of date received by K.C.C.

Important procedures to follow:

1. Notify District office before setting surface casing.
2. Set surface casing by circulating cement to the top.
3. File completion forms ACO-1 with K.C.C. within 120 days of well spud date, following instructions on ACO-1, side 1, and including copies of wireline logs.
4. Notify District office 48 hours prior to old well workover or re-entry.
5. Prior to filing Intent, prepare a proposed plugging plan in case well is D & A, then obtain approval of plan when calling district office prior to setting surface pipe.
6. Submit plugging report (CP-4) to K.C.C. after plugging is completed.
7. Obtain an approved injection docket number before disposing of salt water.

A Regular Section of Land
1 Mile = 5,280 Ft.

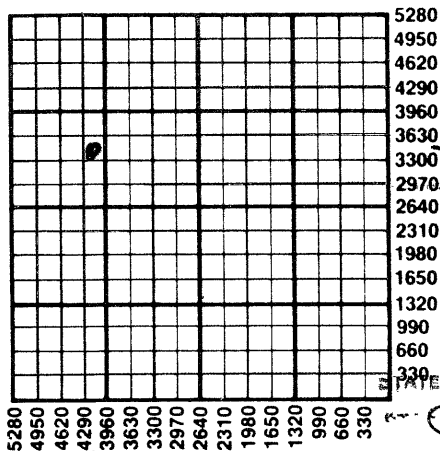

RECEIVED
 STATE CORPORATION COMMISSION

05-07-87
 MAY 7 1987

Notify K.C.C. within 10 days when injection commences or termi-

If an alternate 2 completion, cement in the production pipe from below any usable water to surface within 120 days of spud date.

CONSERVATION DIVISION
 Wichita, Kansas

State Corporation Commission of Kansas
 Conservation Division
 200 Colorado Derby Building
 Wichita, Kansas 67202-1212
 (316) 263-3238