

CARD MUST BE TYPED

State of Kansas

CARD MUST BE SIGNED

NOTICE OF INTENTION TO DRILL

(see rules on reverse side)

Expected Spud Date..... 7 17 1988
 month day year

API Number 15- 121-26,929 - 00 - 00

OPERATOR: License # 5095

NE SW NE Sec. 30 Twp. 16 S, Rg. 22 X East

..... 3800 Ft. from South Line of Section

..... 1600 Ft. from East Line of Section

(Note: Locate well on Section Plat on reverse side)

Nearest lease or unit boundary line 1040 feet

County..... MIAMI.....

Lease Name..... McCANN Well # WW-12

Ground surface elevation feet MSL

Domestic well within 330 feet: ___yes Xno

Municipal well within one mile: ___yes Xno

Depth to bottom of fresh water 30

Depth to bottom of usable water 200

Surface pipe by Alternate: 1 2 X

Surface pipe planned to be set 20

Conductor pipe required None

Projected Total Depth 900 feet

Formation..... Bartlesville.....

Name GERALD E. WILLIAMS

Address P.O. Box 25830

City/State/Zip Overland Park, Kans. 66225

Contact Person..... Gerald E. Williams

Phone..... (913) 451-6022

CONTRACTOR: License # 5885

Name Alva G. Glaze Drlg. Co.

City/State..... Olathe, Kansas 66062

Well Drilled For: Well Class: Type Equipment:

___ Oil ___ Storage X Infield ___ Mud Rotary

___ Gas X Inj ___ Pool Ext. X Air Rotary

___ OWWO ___ Expl ___ Wildcat ___ Cable

If OWWO: old well info as follows:

Operator

Well Name

Comp Date..... Old Total Depth.....

I certify that well will comply with K.S.A. 55-101, et seq., plus eventually plugging hole to KCC specifications.

Date 7-12-88 Signature of Operator or Agent Frank Brantford

Title..... Agent

For KCC Use:

Conductor Pipe Required feet; Minimum Surface Pipe Required 20 feet per Alt. X (2)

This Authorization Expires 1-12-89 Approved By LKM 7-12-88


EFFECTIVE DATE: 7-19-89

Must be filed with the K.C.C. five (5) days prior to commencing well
This card void if drilling not started within six (6) months of date received by K.C.C.

Important procedures to follow:

1. Notify District office before setting surface casing.
2. Set surface casing by circulating cement to the top.
3. File completion forms ACO-1 with K.C.C. within 120 days of well spud date, following instructions on ACO-1, side 1, and including copies of wireline logs.
4. Notify District office 48 hours prior to old well workover or re-entry.
5. Prior to filing Intent, prepare a proposed plugging plan in case well is D & A, then obtain approval of plan when calling district office prior to setting surface pipe.
6. Submit plugging report (CP-4) to K.C.C. after plugging is completed.
7. Obtain an approved injection docket number before disposing of salt water.
8. Notify K.C.C. within 10 days when injection commences or terminates.
9. If an alternate 2 completion, cement in the production pipe from below any usable water to surface within 120 days of spud date.

A Regular Section of Land 1 Mile = 5,280 Ft.

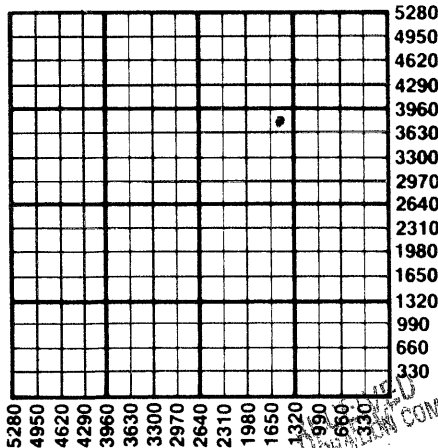

STATE CORPORATION COMMISSION
WICHITA, KANSAS

JUL 12 1988

CONSERVATION DIVISION
Wichita, Kansas

State Corporation Commission of Kansas
Conservation Division
200 Colorado Derby Building
Wichita, Kansas 67202-1212
(316) 263-3238